

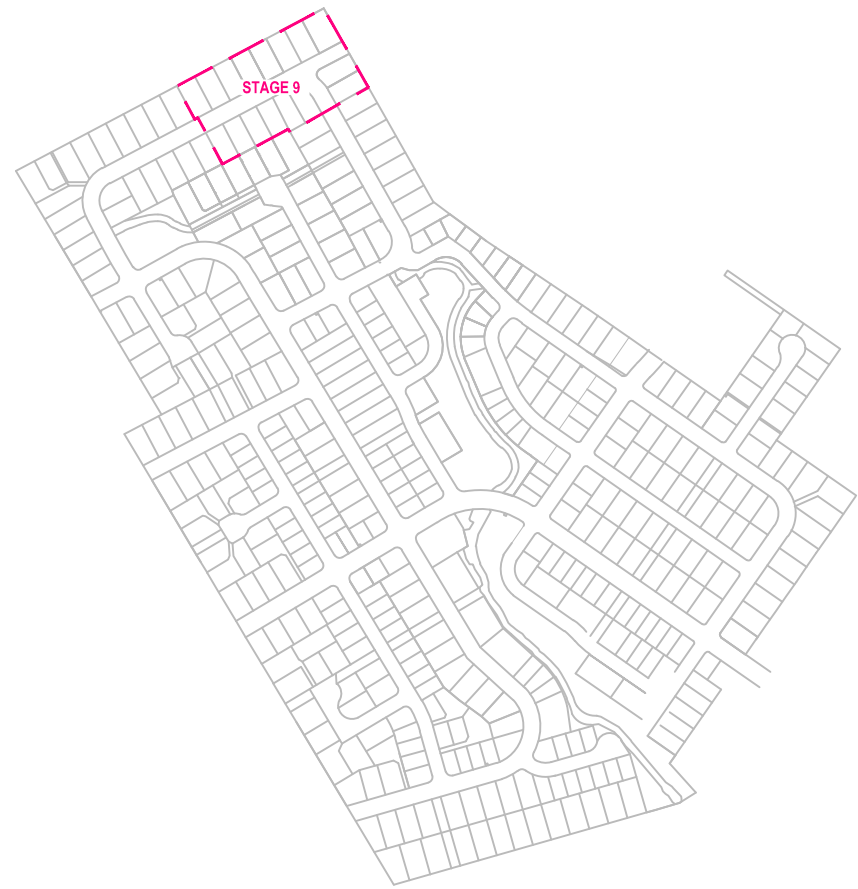


NOTES:

AS BUILT INFORMATION HAS BEEN SUPPLIED BY KBs
CONTRACTING & QUARRIES LTD - AUGUST 2014.
HEIGHTS ARE IN TERMS OF MEAN SEA LEVEL
ALL LATERALS ARE 100mmØ uPVC SN16

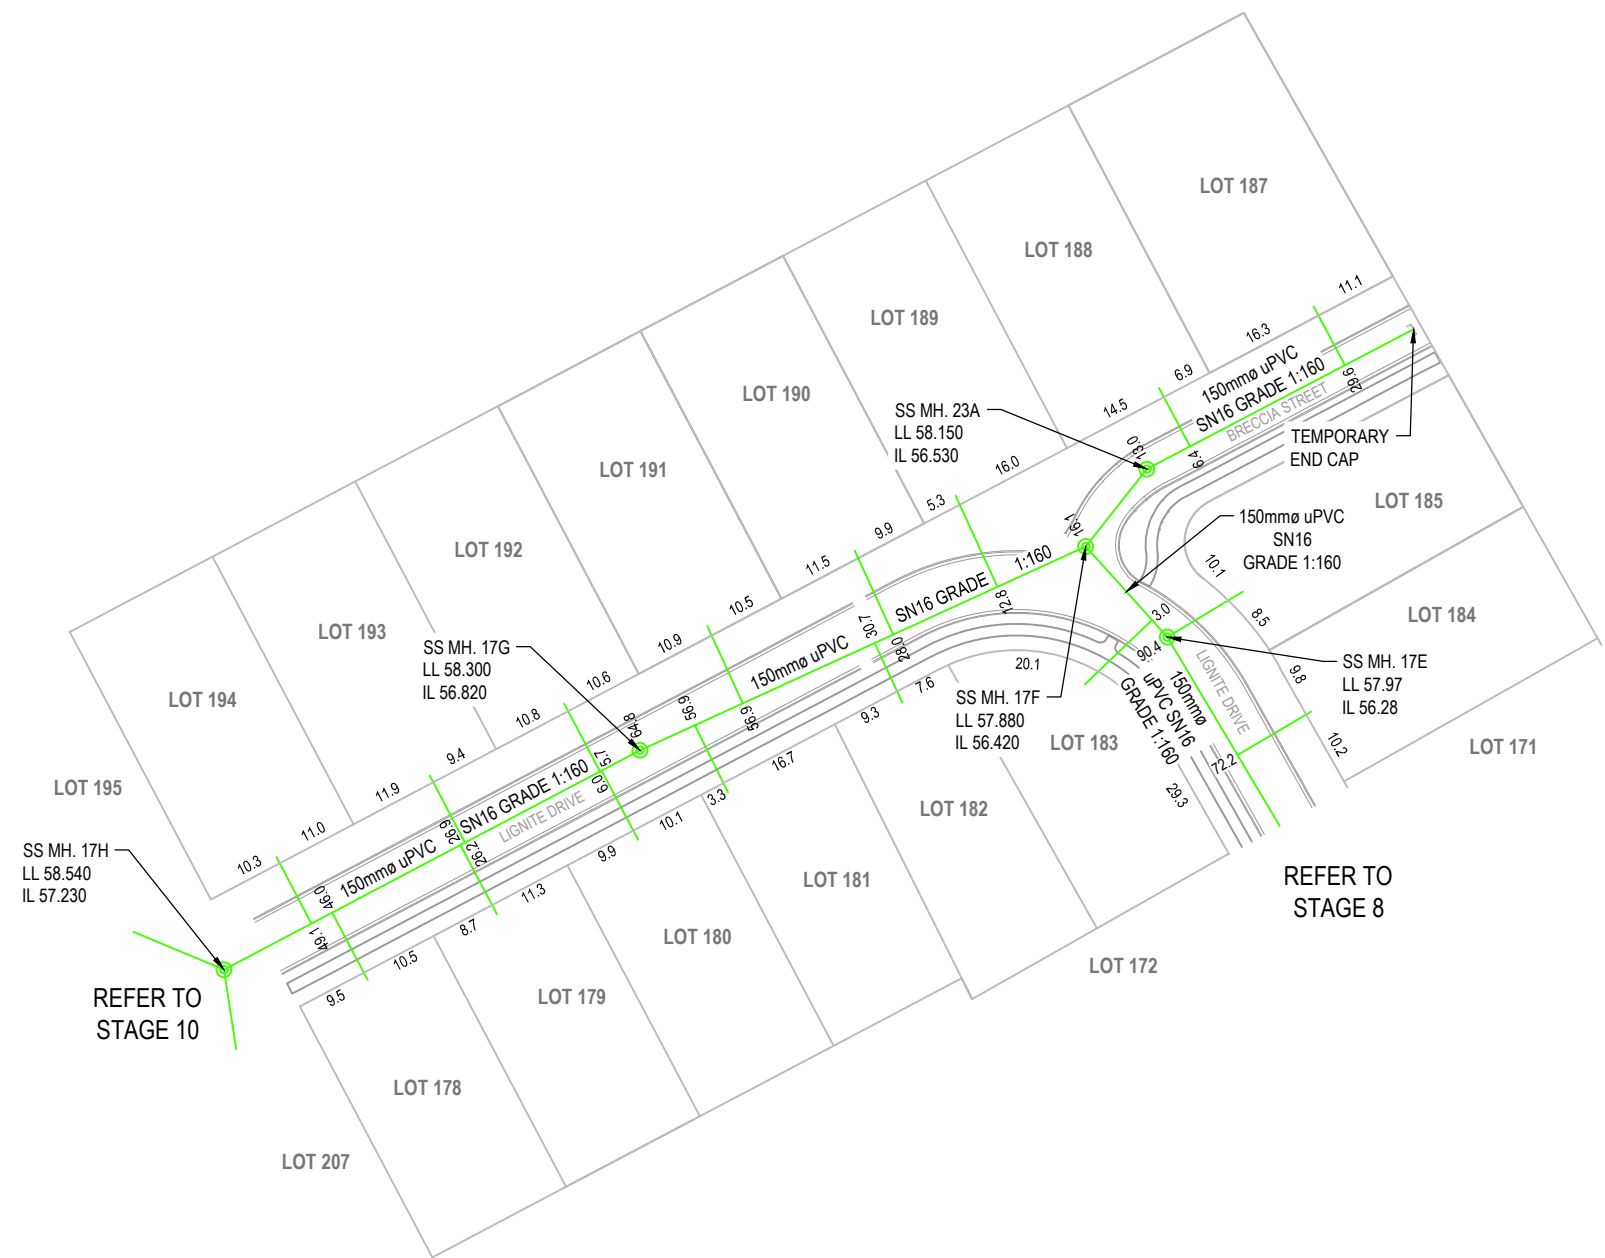

LOCATION PLAN

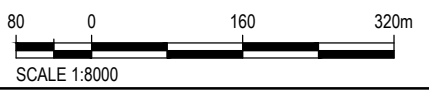

CLIENT	REV	DATE	REVISION DETAILS	APPROVED	DRAWN	DESIGNED	PROJECT		AS BUILT	
					A.COLUMBUS	M.CROWE	STONEBROOK ROLLESTON		PROJECT No.	
					CHECKED				224926	
					D.WATSON				SCALE	
					APPROVED		TITLE		AS SHOWN	
					DATE		STAGE 9		SIZE	
							SEWER		A3	
							AS BUILTS		DRAWING No.	
									REV	
	A	15.09.14	AS BUILTS ISSUED	B.TOMS	B.TOMS				DW-LD-S9-AB-SS-01	A