

NOTES: AS BUILT INFORMATION HAS BEEN SUPPLIED BY KBs CONTRACTING & QUARRIES LTD - OCTOBER 2013. HEIGHTS ARE IN TERMS OF MEAN SEA LEVEL ALL LATERALS ARE 100mmØ uPVC





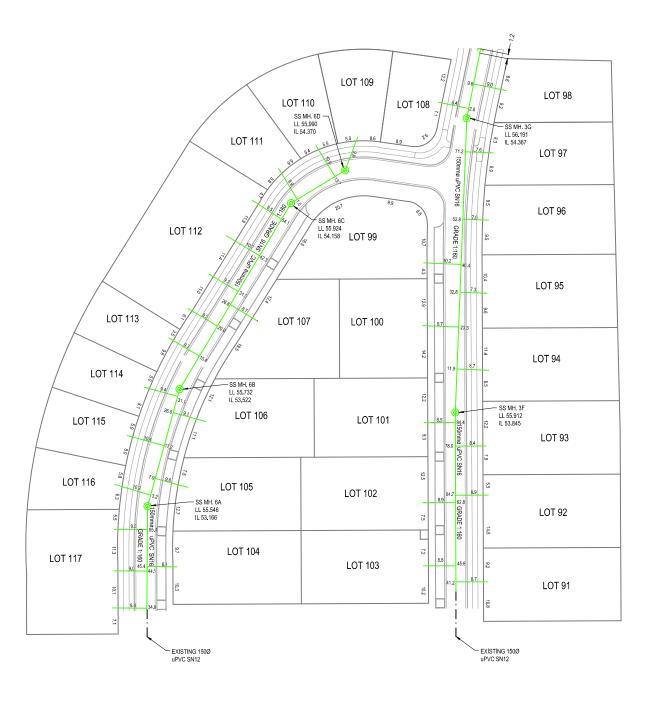

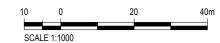

CLIENT

				50/ KE 1:1000			
REV DAT	E REVISION DETAILS	APPROVED	DRAWN	DESIGNED	PROJECT	AS BUILT	
			A GRAY	M CROWE	CTONEDDOOK DOLLECTON		
			CHECKED		STONEBROOK ROLLESTON	PROJECT No.	
			D WATSON			224926	
			APPROVED		TITLE		SIZE
			DATE		STAGE 4	1:1000	A3
					SEWER		REV
							KEV A
A 01-11-	13 AS BUILTS ISSUED		B TOMS		AS BUILTS	DW-LD-S2-AB-SS-01	Α