
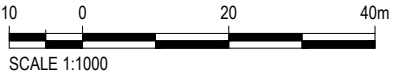


Notes:  
AS BUILT INFORMATION HAS BEEN SUPPLIED BY KBs CONTRACTING  
& QUARRIES LTD - OCTOBER 2013  
HEIGHTS ARE IN TERMS OF MEAN SEA LEVEL  
ALL LATERALS ARE 100mmØ UPVC  
-0.0 ZERO FILL CONTOUR  
0.0 DEPTH OF FILL CONTOUR

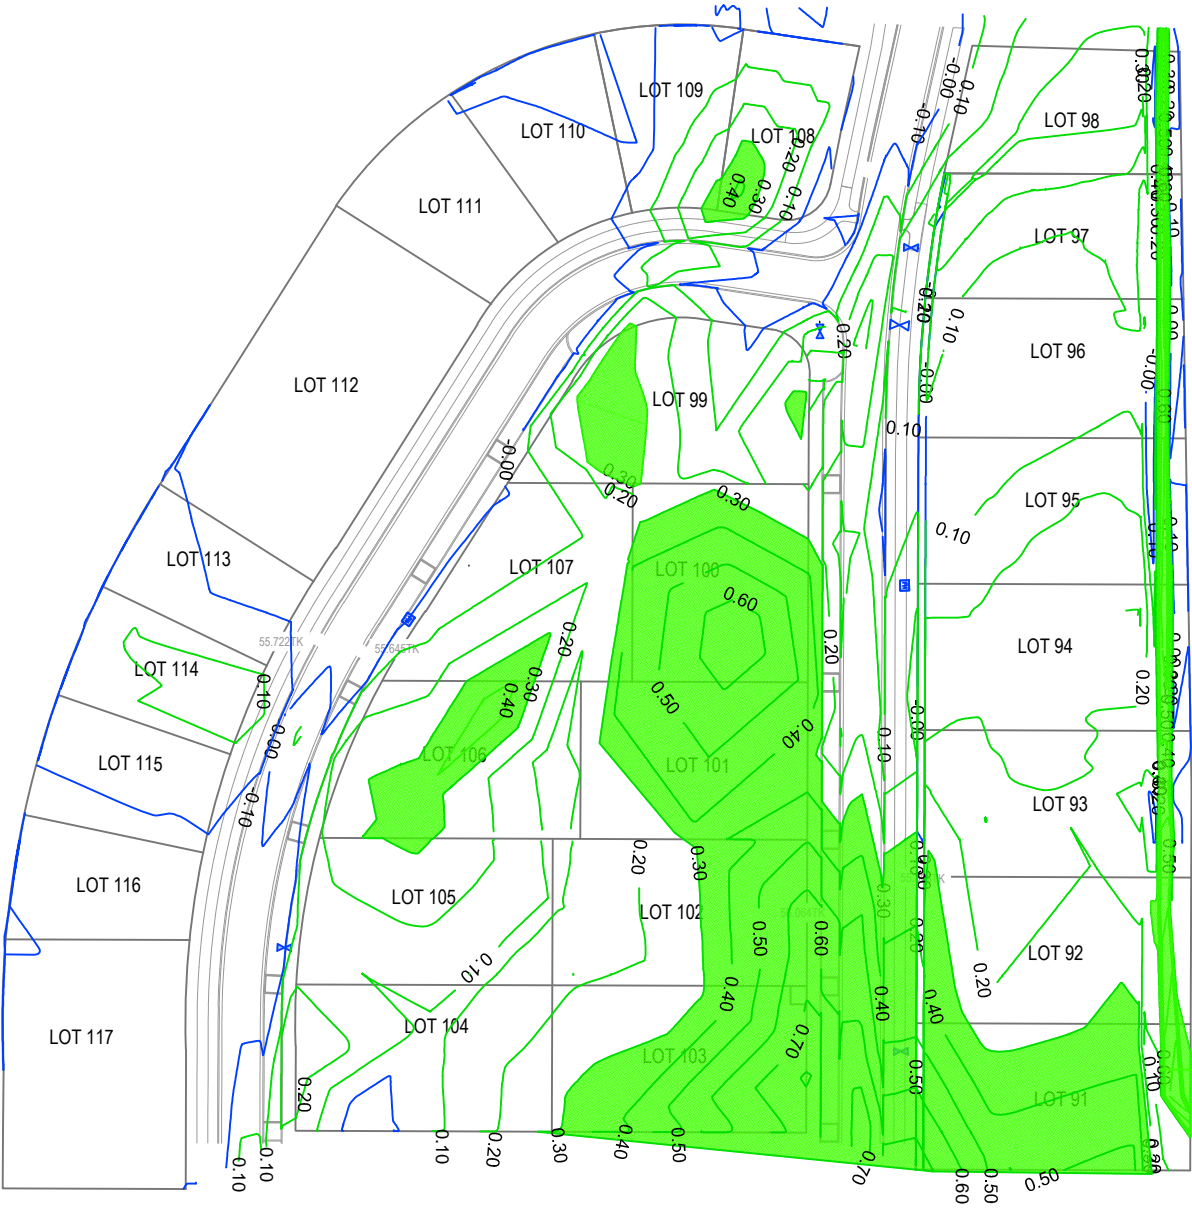

CLIENT		REV	DATE	REVISION DETAILS	APPROVED	DRAWN	DESIGNED	PROJECT		AS BUILT	
						A GRAY	M CROWE	STONEBROOK ROLLESTON		PROJECT No.	
						CHECKED				224926	
						D WATSON				SCALE	SIZE
						APPROVED	DATE	TITLE		1:1000	A3
								STAGE 4		DRAWING No.	REV
								FILL CONTOURS		DW-LD-S2-AB-FC-01	A
								AS BUILTS			
						B TOMS					
		A	01-11-13	AS BUILTS ISSUED							