


LOCATION PLAN

1:4000




SCALE 1:4000

3501  
DP 486184

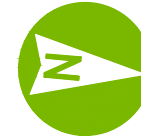

LEGEND

- STORMWATER TO STREET
- SEWER LATERAL TO MAINS
- WATER SUBMAIN

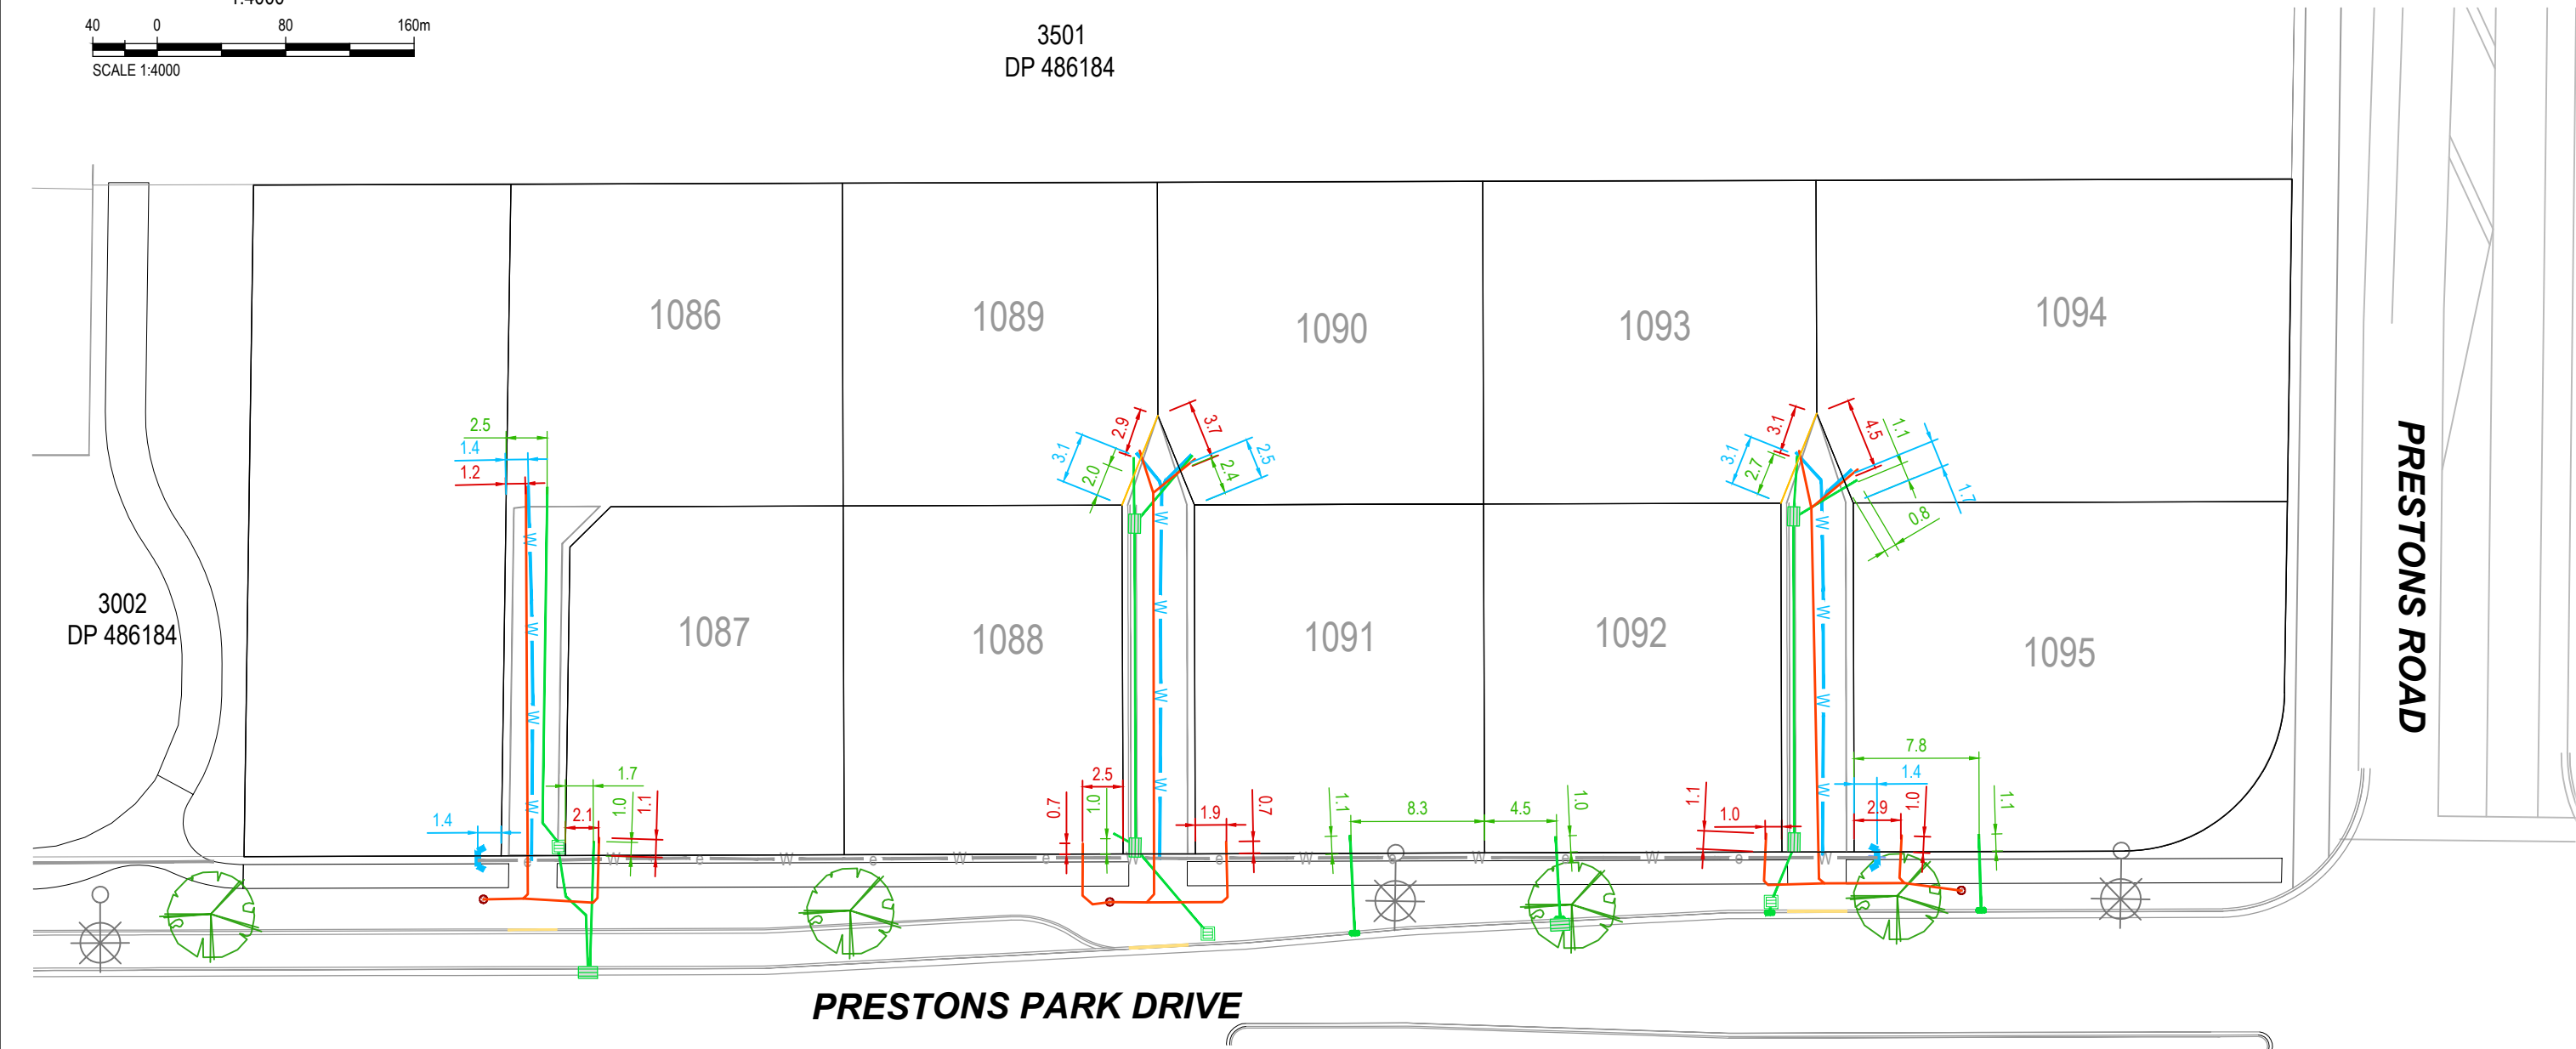

PRESTONS PARK DRIVE



SCALE 1:400

**aurecon**  
www.aurecongroup.com



CLIENT				APPROVED		PROJECT		FOR INFORMATION	
REV	DATE	REVISION DETAILS		K ASHBY		PRESTONS PARK		PROJECT No.	
A	24/07/25	AS BUILT FOR INFORMATION						235361	
								SCALE	
								1:400	
								SIZE	
								A3	
								DRAWING No.	
								LD-PS-DCA-AB-02	
								REV	
								A	