


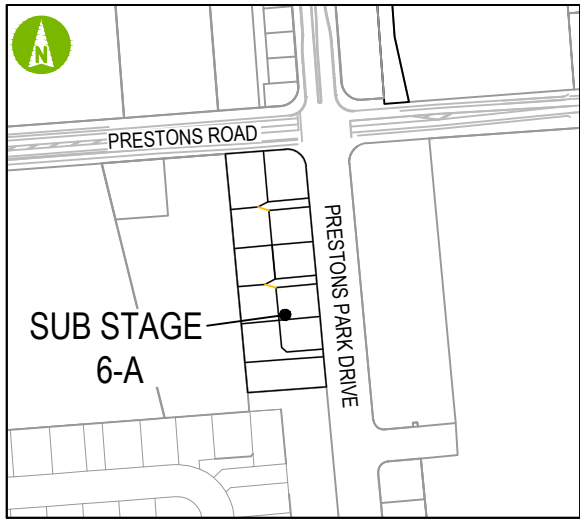

LOCATION PLAN




NOTES:

- KERB LEVELS ARE AT TOP OF KERB.
- SURVEY ORIGIN DATA
- THE PROPERTY DATA HAS BEEN SOURCED FROM AURECON (NOVEMBER 2025) AND IS SUBJECT TO FINAL LEGAL REVIEW BY LAND INFORMATION NEW ZEALAND (LINZ).
 - VERTICAL ELEVATIONS ARE IN TERMS OF CHRISTCHURCH DRAINAGE DATUM, SCIRT PUBLISHED JUNE 2011.
 - THE ORIGIN OF LEVELS IS BM 3257 (EHDK). RL 15.160m

LEGEND

- EXISTING TREE
- STREET LIGHT
- SINGLE SUMP
- CORNER SUMP
- ENTRANCE WALL

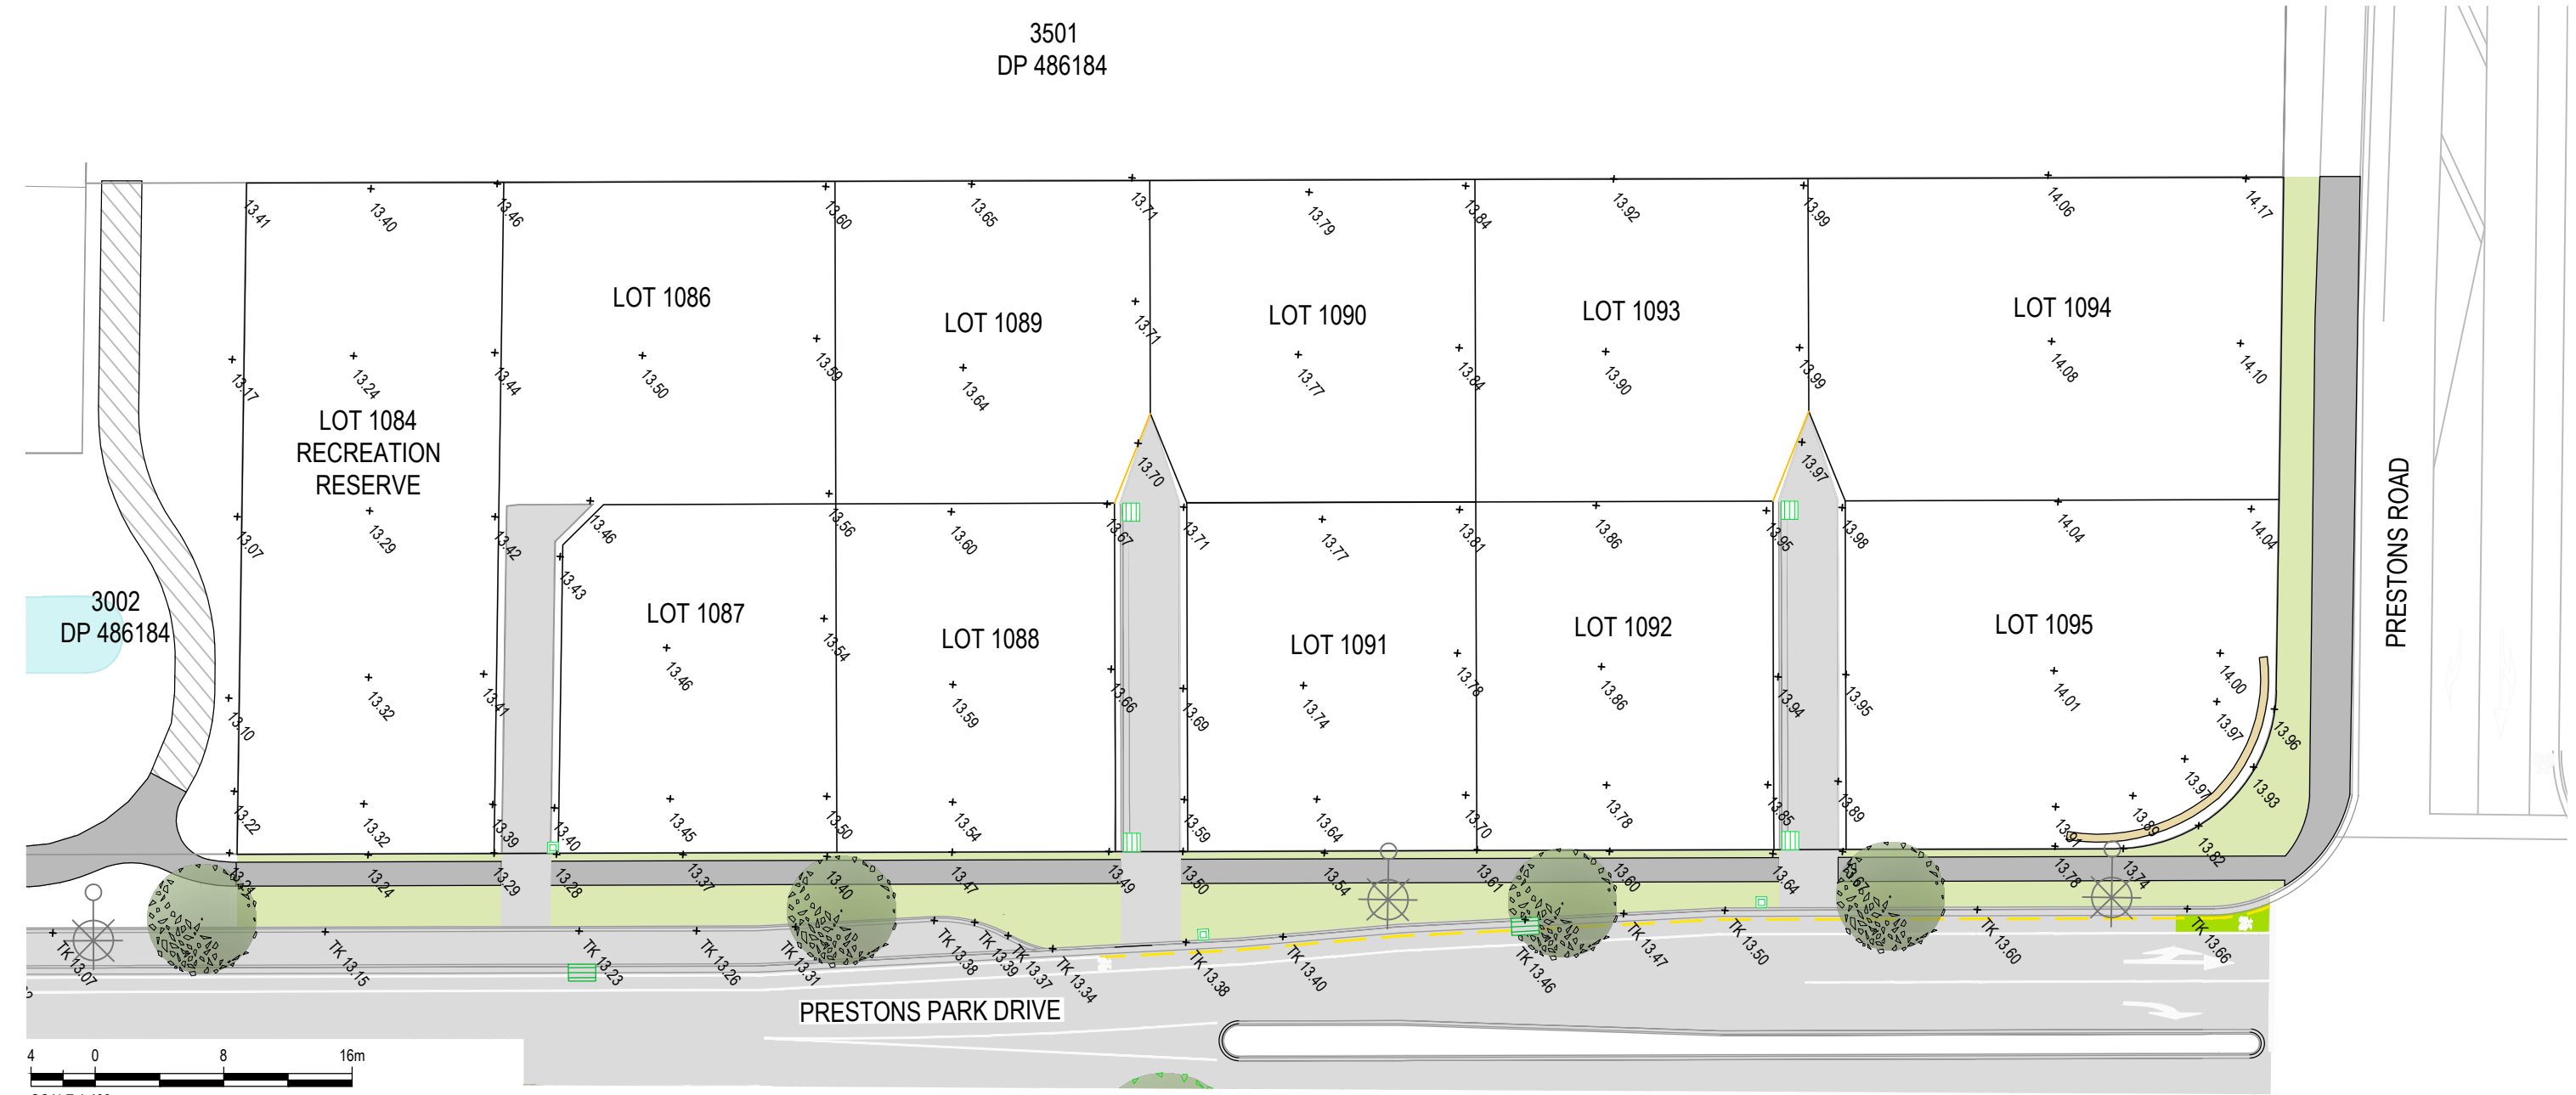

0000000

CLIENT

REV	DATE	REVISION DETAILS	APPROVED
A	24/07/25	ISSUE FOR INFORMATION	K ASHBY

DRAWN	DESIGNED
A COLUMBUS	A COLUMBUS
CHECKED W CLIMO	
APPROVED	DATE 24/07/25
K ASHBY	

PROJECT
PRESTONS PARK
TITLE
SUB STAGE 6-A AS BUILT SPOT HEIGHTS

FOR INFORMATION
PROJECT No. 235361
SCALE 1:400
DRAWING No. SU-PS-S6-IN-16
SIZE A3
REV A