


Cameo Grove, Lot 1, 7th lift

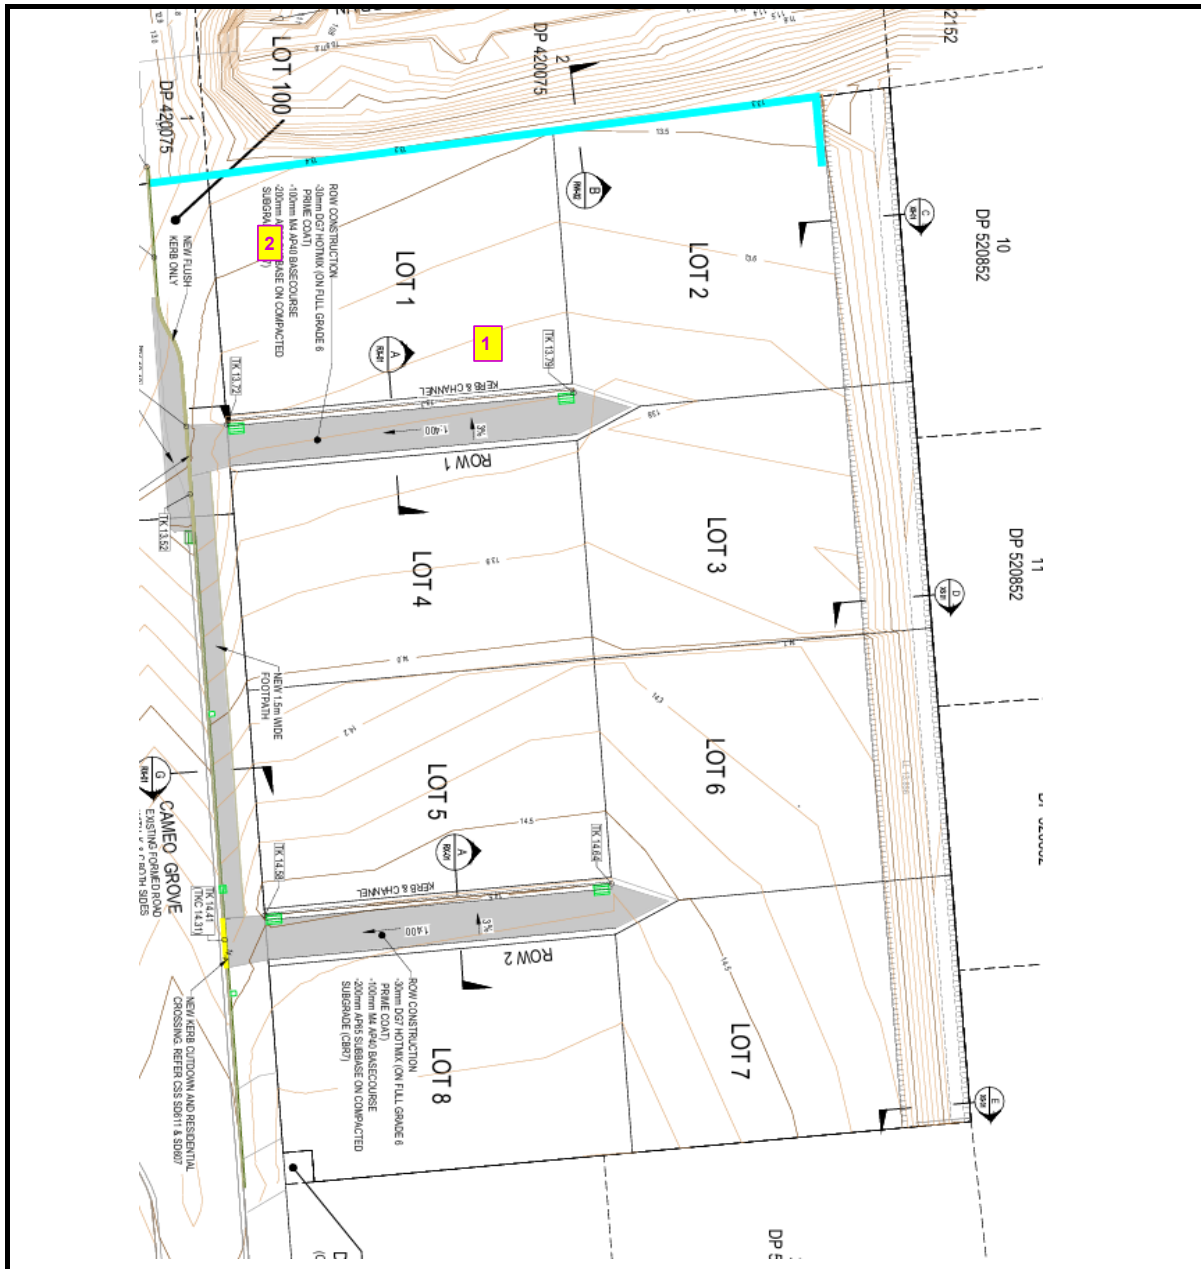

Plans and test locations are not to scale

Notes: *Based on a maximum dry density of 2300 kg/m³ as determined by New Zealand Vibrating Hammer Compaction (Refer Road Science Lab Ref: C25/1991, Issued 6 June 2025)
2 test sites were randomly selected as representative sample locations in each lot.

Test Report

Page 1 of 2 Pages

Laboratory No: KB25/0474

Report Date: 20/08/2025

Report Status: Final


Client: KB Contracting and Quarries Ltd
Contact Name: Mr A Hodgson
Location: Cameo Grove, Lot 2, 6th lift
Material: Pit Run
Material Source: McLeans Island Quarry
Contractor: KB Contracting and Quarries Ltd

Tested By: M. Foster
Date Tested: 19/08/2025

Test Method: NZS 4407:2015 Test 4.3 (backscatter mode)
Note: Moisture contents and dry densities as reported by the nuclear gauge


Results:

Location	Dry Density (kg/m ³)	Wet Density (kg/m ³)	Moisture (%)	* Relative Compaction (%)
1	2200	2310	5.3	95
2	2180	2300	5.4	95

Issued By:

(M. Foster, Laboratory Supervisor)

Cameo Grove, Lot 2, 6th lift

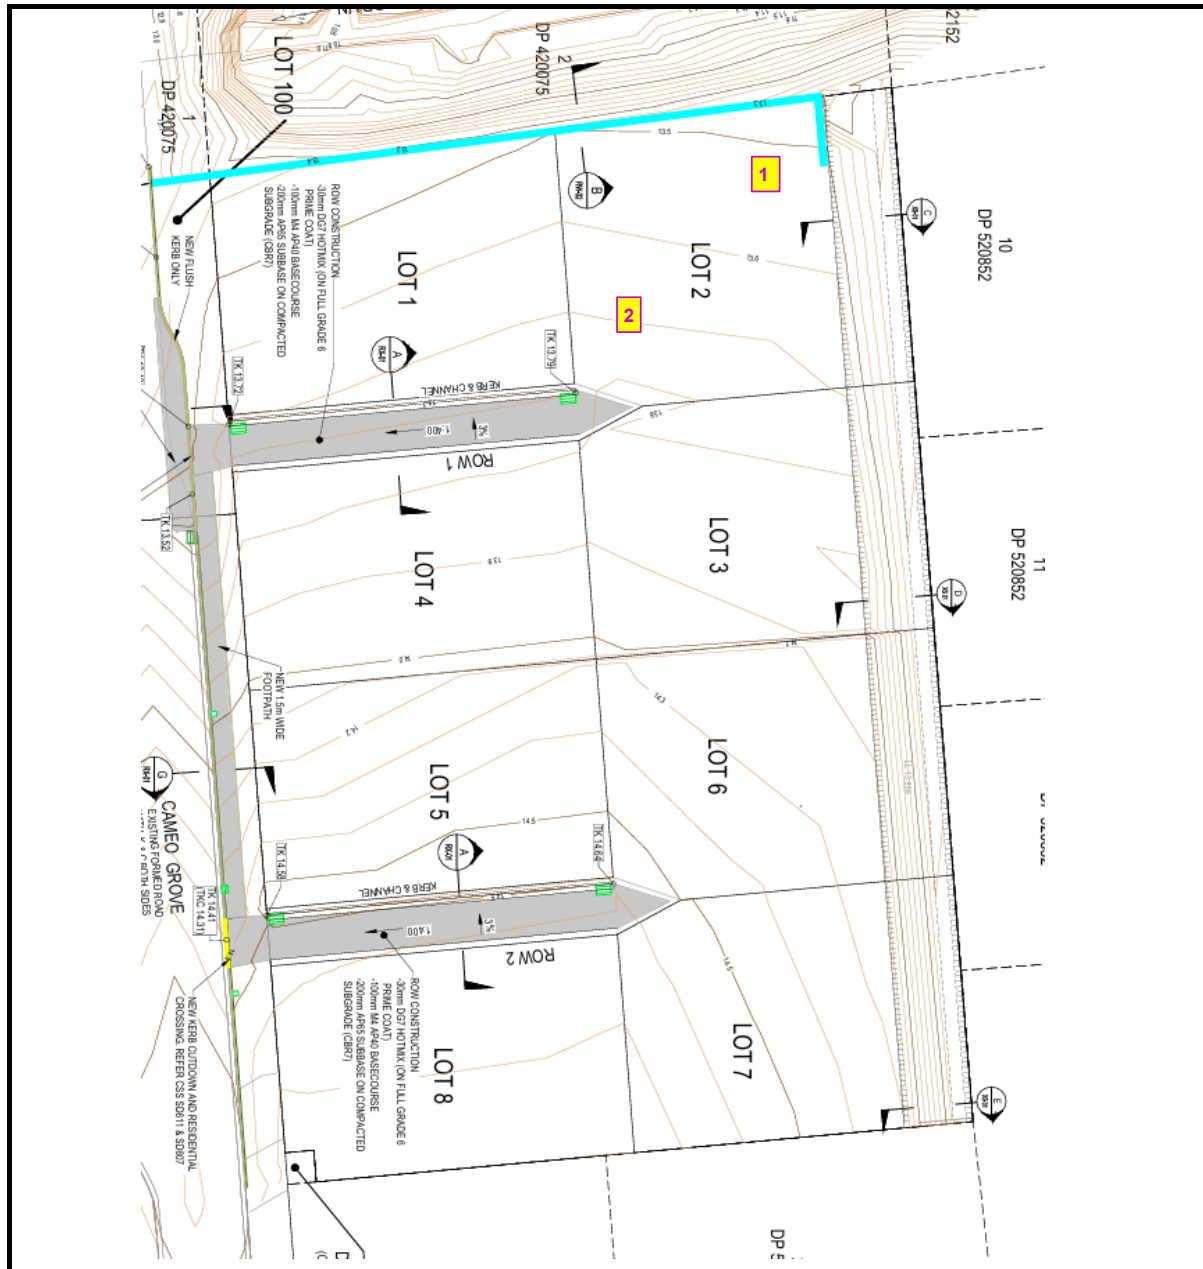

Plans and test locations are not to scale

Notes: *Based on a maximum dry density of 2300 kg/m³ as determined by New Zealand Vibrating Hammer Compaction (Refer Road Science Lab Ref: C25/1991, Issued 6 June 2025)
2 test sites were randomly selected as representative sample locations in each lot.

Appendix D

Earthfill Certification

APPENDIX D – STATEMENT OF SUITABILITY OF ENGINEERED FILL FOR LIGHTWEIGHT STRUCTURES

(Informative)

To: (name and address of local authority)	CHRISTCHURCH CITY COUNCIL
Development name:	PRESTONS PARK CAMEO GROVE
Land title(s):	LOT 46 DP 431366
Development location/address:	12 CAMEO GROVE
Relevant resource consent number(s):	RMA/2024/1142/A
Developer's name and company:	CDL LANE NEW ZEALAND LIMITED
Geotechnical designer's name and company:	JAN KUPEC - AURECON NEW ZEALAND LIMITED
Certifier's name and company:	JAN KUPEC - AURECON NEW ZEALAND LIMITED
<p>Attachments (give reference numbers):</p> <ol style="list-style-type: none"> (1) Site layout plan(s) (2) Fill layout plan(s) (3) Fill section(s) (4) Design report (5) Earthworks completion report, including the following appendices: <ol style="list-style-type: none"> (a) As-built survey; (b) Cut-fill plan (with contours); (c) Inspection and test plan; (d) Earthworks specification; (e) All test results; (f) All inspection records. 	
<p>I confirm I am qualified as a certifier as defined in NZS 4431:2022.</p> <p>During this work, I was retained as certifier, and I or my certifier's representative undertook inspections and testing as documented in the attached earthworks completion report.</p> <p>I am satisfied that the engineered fill shown in the attached as-built survey was placed, compacted, and tested in accordance with the attached earthworks specification and that all variations and non-compliances have been documented in the earthworks completion report.</p> <p>Based on the information available, I certify that, to the best of my knowledge, the intent of the geotechnical designer (as presented in their design, drawings, and earthworks specification) has been achieved.</p> <p>The area shown on the as-built survey plan referenced above is considered suitable for development as per NZS 3604. (<i>strike out if not relevant</i>)</p> <p>This certification does not remove the necessity for normal inspection and design of foundations as would be made in natural ground.</p>	
Certifier's signature:	Date: 22/10/25
<p>Certifier's qualifications, professional registration type, and number:</p> <p>PhD, MSc, FEngNZ, CPEng (Geotechnical and Project Management), IntPE</p>	

Figure 12 – Statement of suitability of engineered fill for lightweight structures

Document prepared by

Aurecon New Zealand Limited

Level 2, Iwikau Building
93 Cambridge Terrace
Christchurch 8013
New Zealand

T +64 3 366 0821

F +64 3 379 6955

E christchurch@aurecongroup.com

W aurecongroup.com