




PIPELINE - 2B
HORIZONTAL 1:500
VERTICAL 1:50

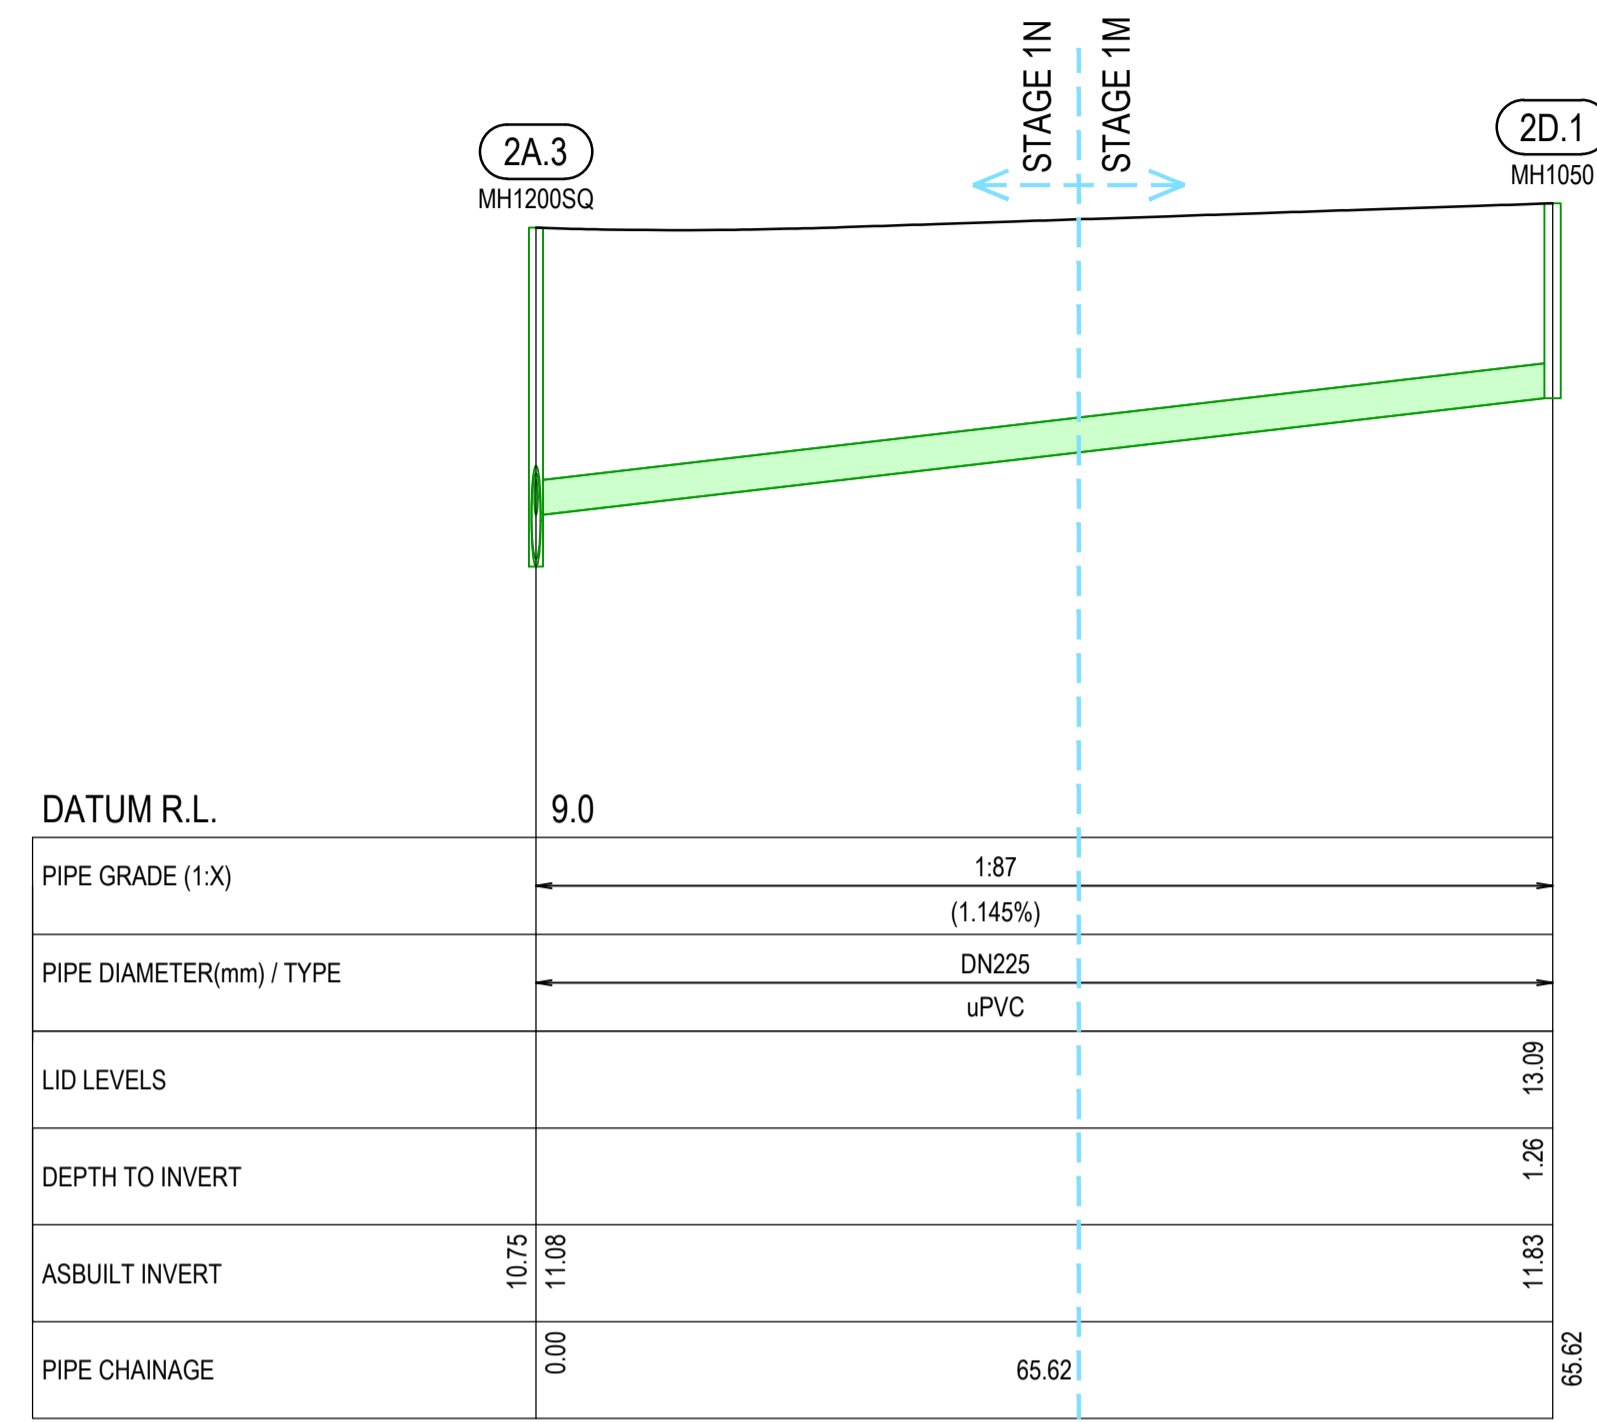


PIPELINE - 2D
HORIZONTAL 1:500
VERTICAL 1:50

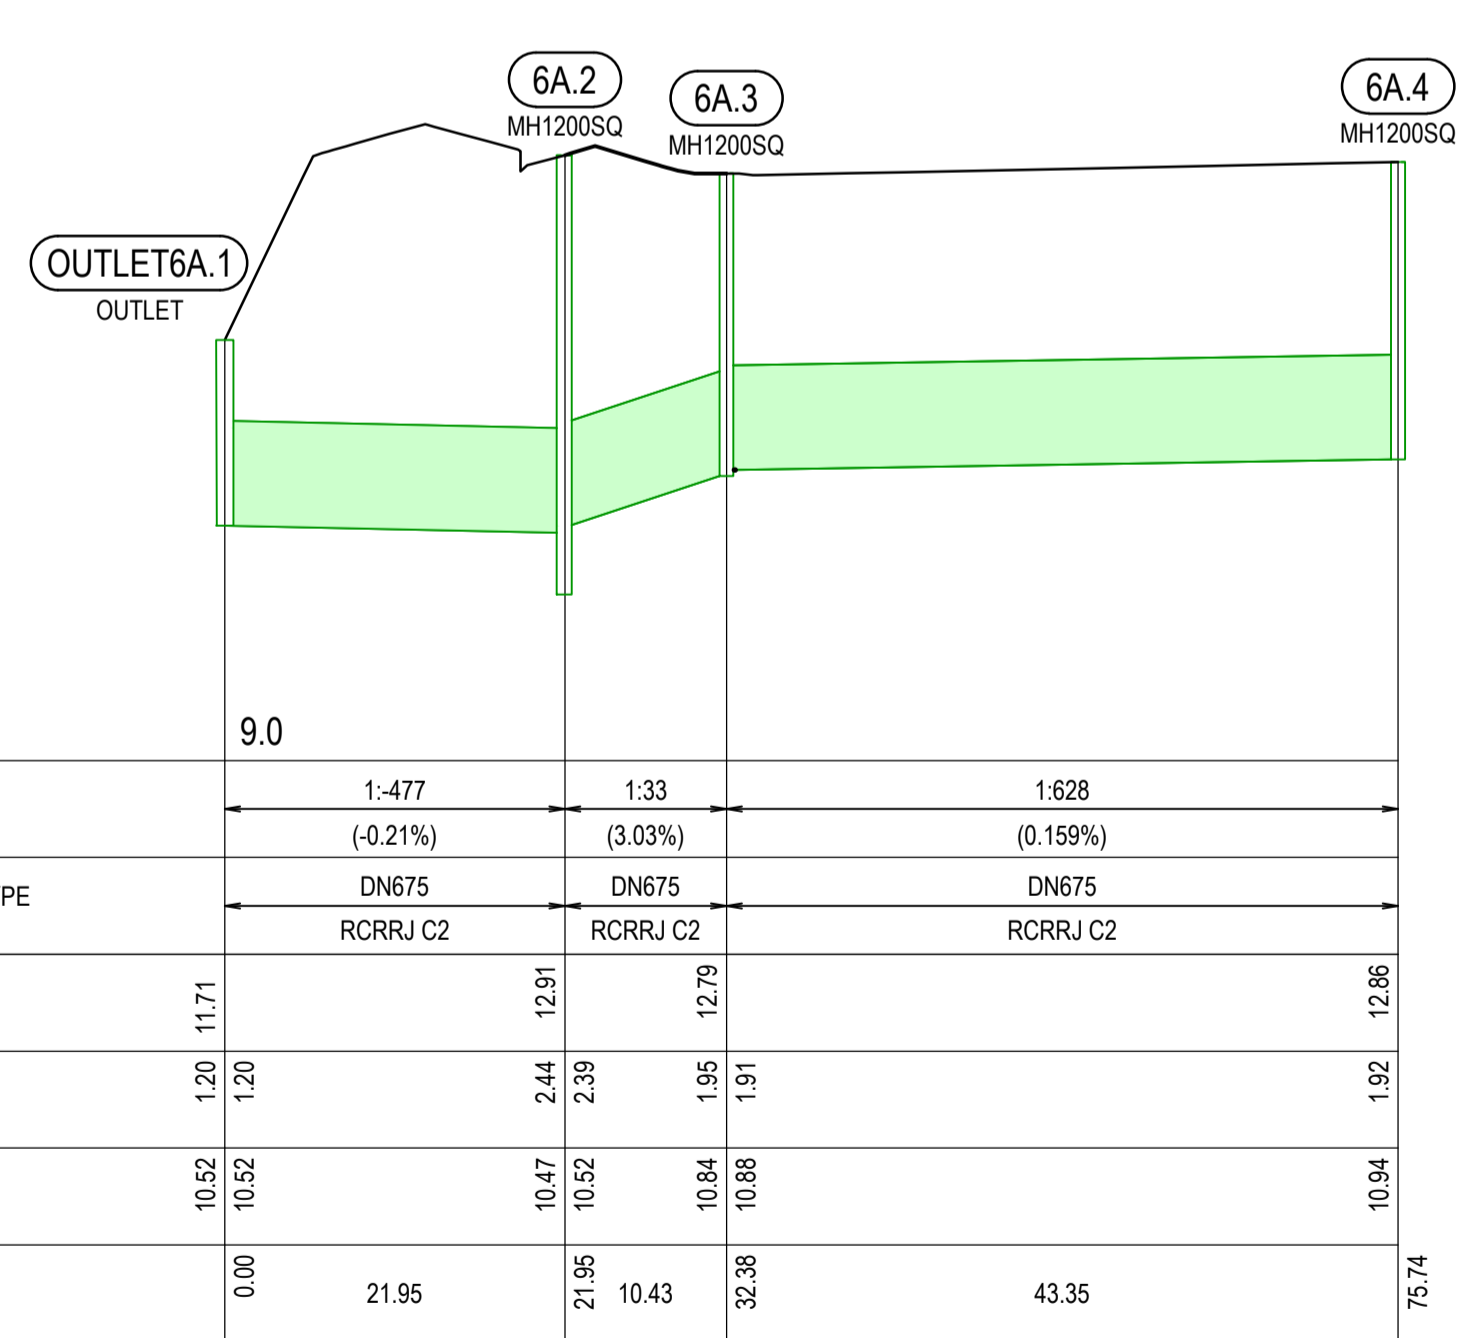


PIPELINE - 6A
HORIZONTAL 1:500
VERTICAL 1:50

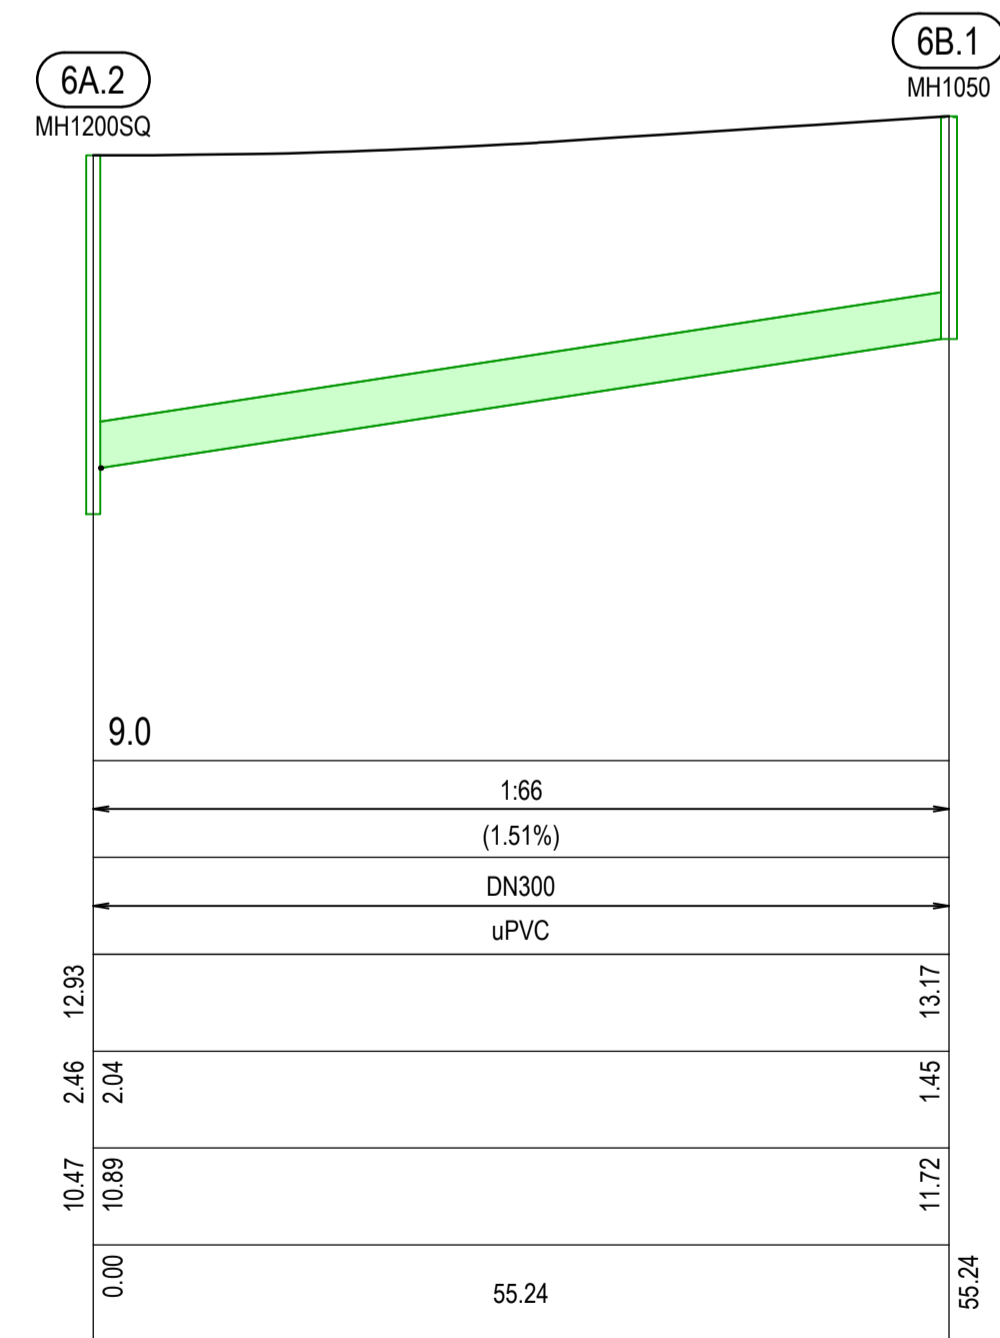

PIPELINE - 6B
HORIZONTAL 1:500
VERTICAL 1:50

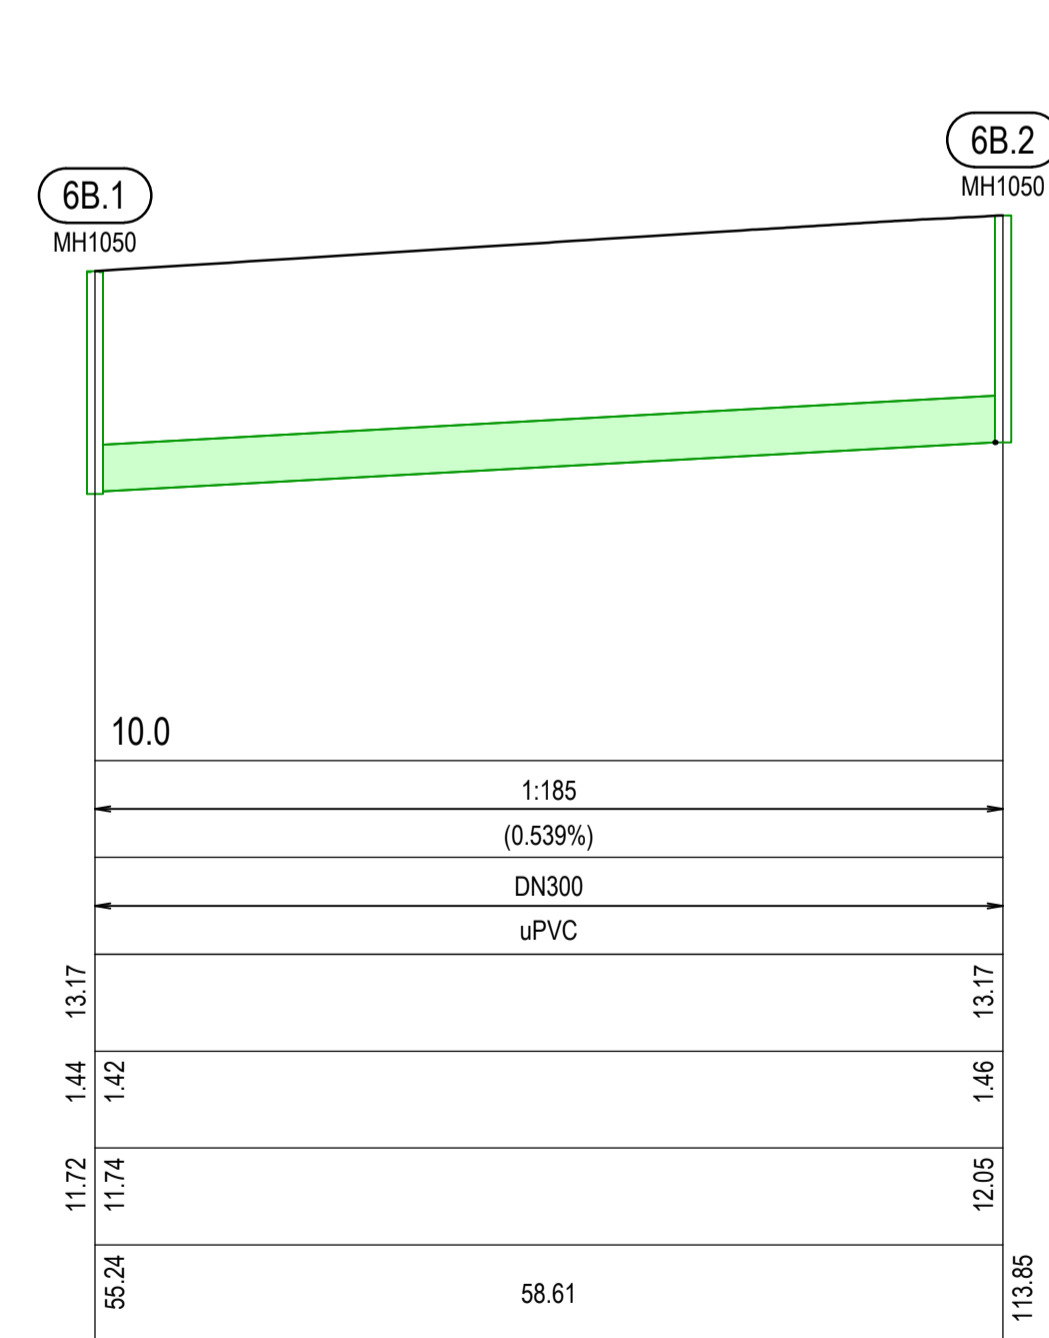


PIPELINE - 6B
HORIZONTAL 1:500
VERTICAL 1:50

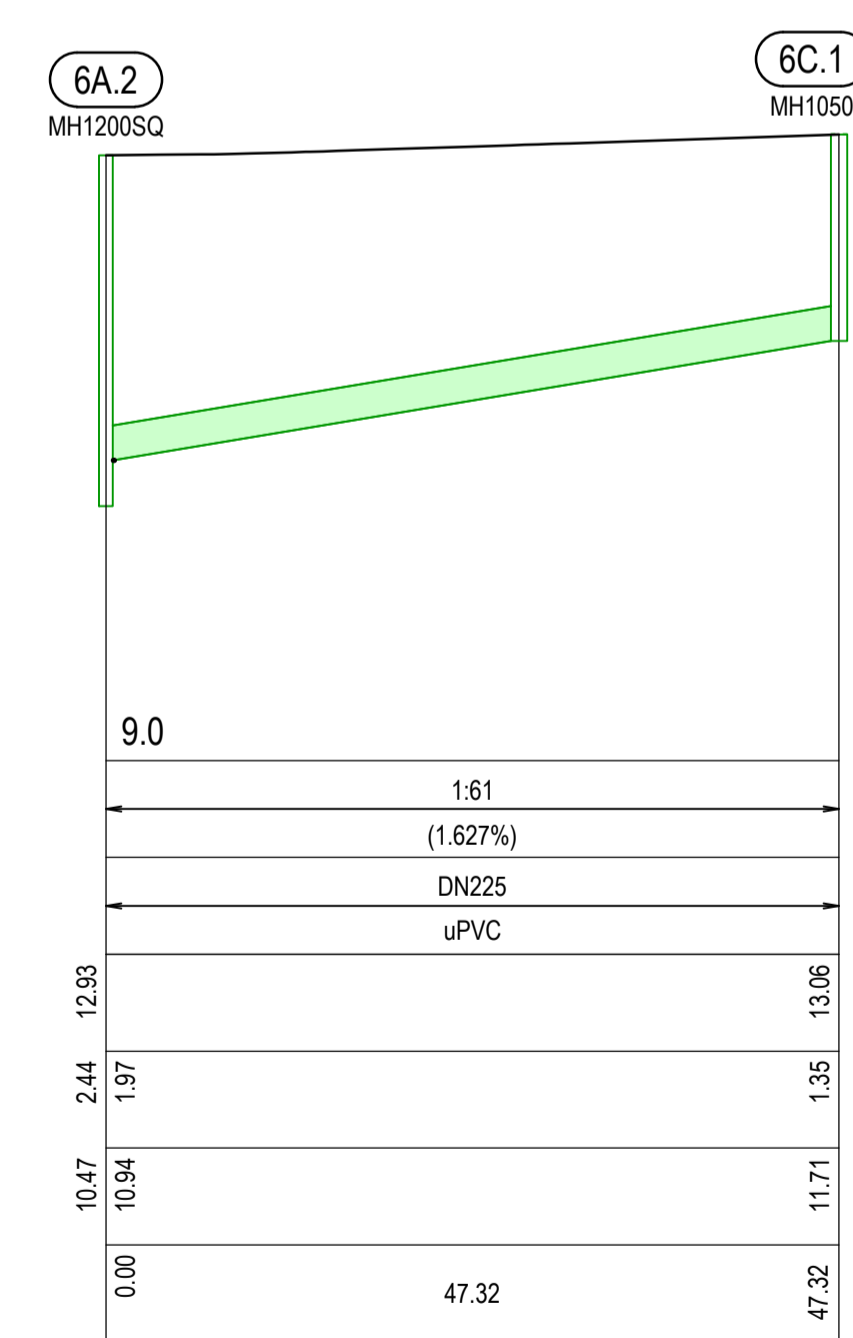

PIPELINE - 6C
HORIZONTAL 1:500
VERTICAL 1:50

- LEGEND:**
- FINISHED SURFACE LEVEL
 - STORMWATER PIPE
 - STORMWATER MANHOLE

This AS BUILT drawing has been prepared based on information provided by the contractor.

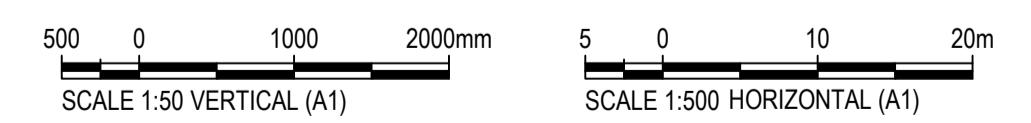

REV	DATE	REVISION DETAILS	APPROVED
1	08/08/15	AS BUILT	K.ASHBY

DRAWN	DESIGNED
M.PEPERE	I.DUNCAN
CHECKED	
S.HUSBAND	
APPROVED	
DATE 08/08/15	
K.ASHBY	K.ASHBY

PROJECT
PRESTONS SOUTH
TITLE
PRESTONS SOUTH - STAGE 1 STORMWATER AS BUILT LONGSECTIONS SHEET 2 OF 3

AS BUILT
PROJECT No. 235361
SCALE AS SHOWN
DRAWING No. AB-PS-S1-SL-02
SIZE A1
REV 1