





SHEET LAYOUT:

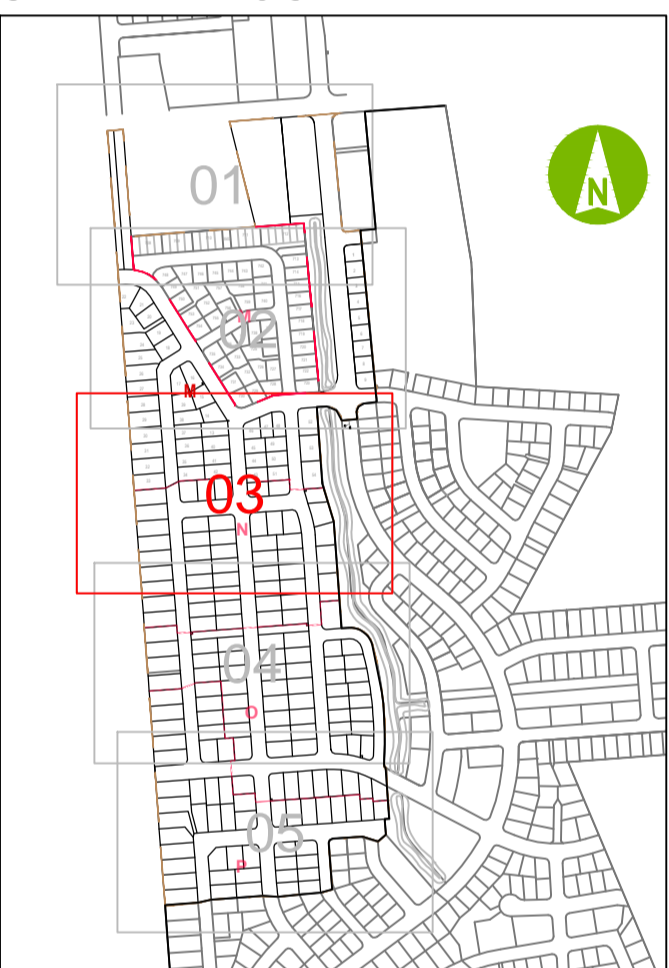

- LEGEND:**
- STAGE BOUNDARY
 - STAGE M BOUNDARIES
 - VACUUM MAINS PE100 PN12.5 SDR13.6
 - 9000
 - 12500
 - 16000
 - 20000
 - 25000
 - 28000
 - FLOVAC VACUUM INTERFACE VALVE
 - ECCENTRIC REDUCER
 - DIVISION VALVE
 - MAINTENANCE RISER
 - VACUUM SEWER VENT INTAKE PILLAR
 - CONCRETE CAPPING
 - LIFT

This AS BUILT drawing has been prepared based on information provided by the contractor.

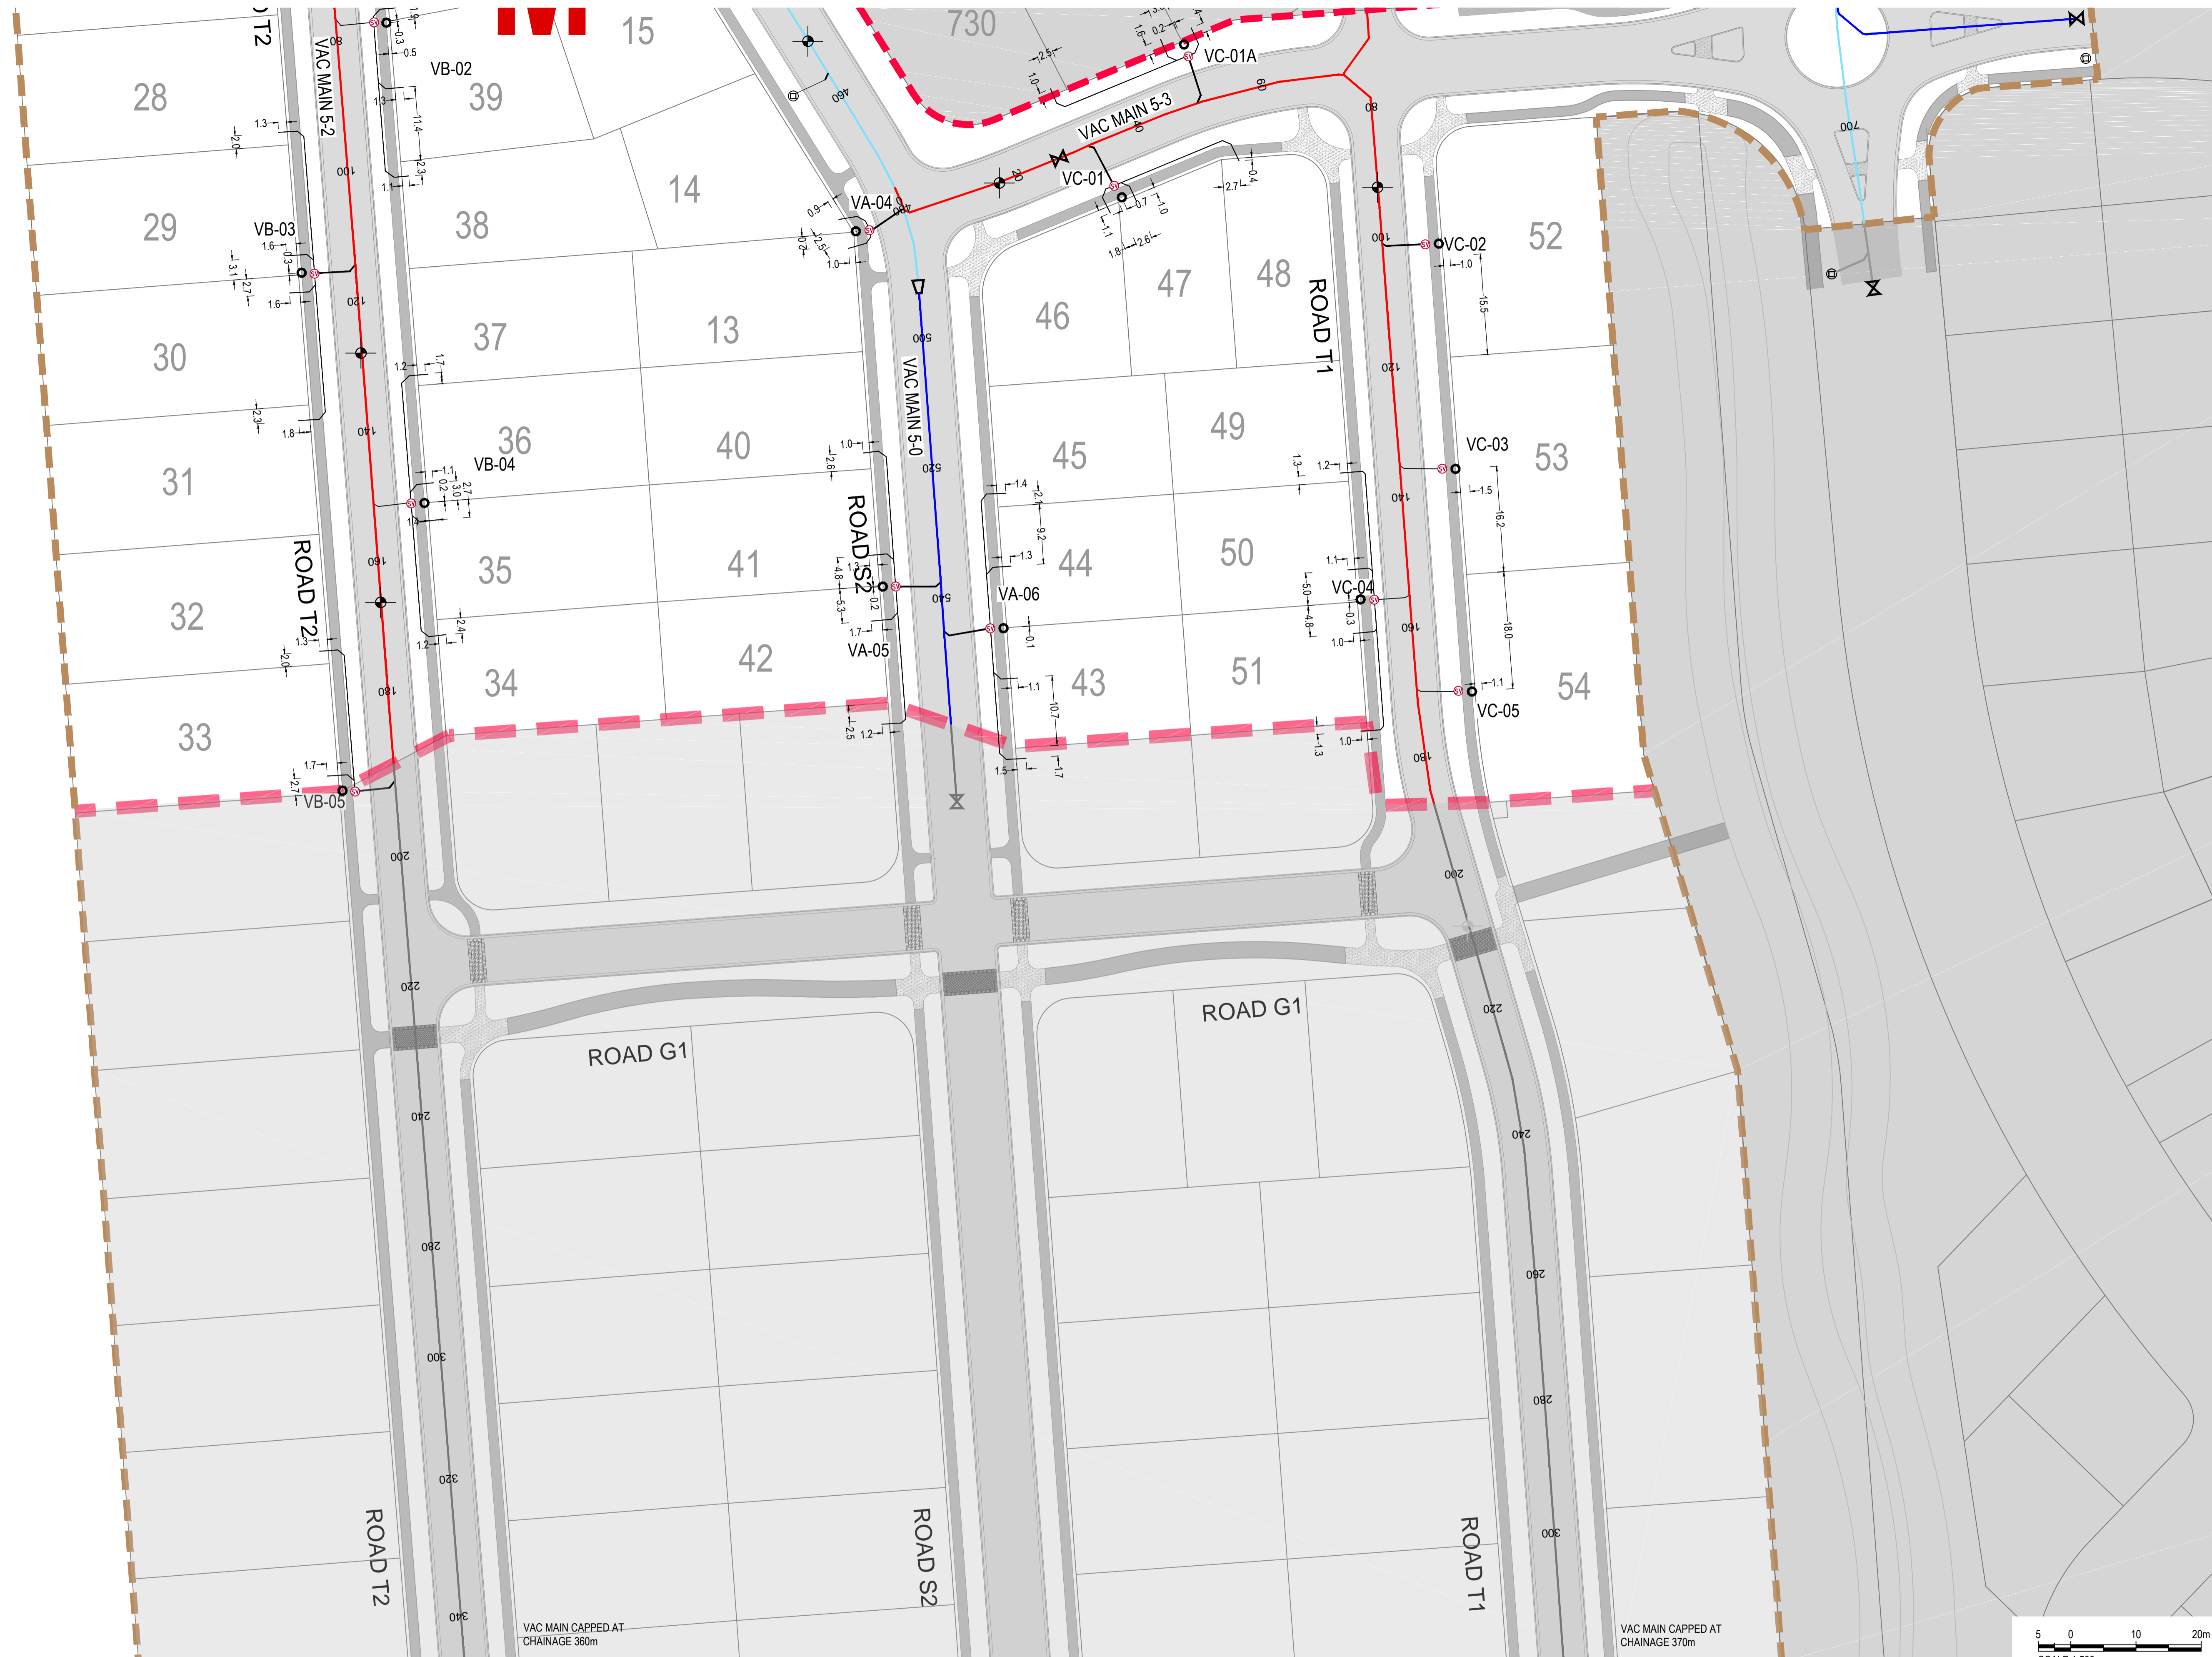

CLIENT

REV	DATE	REVISION DETAILS	APPROVED
1	18/03/15	AS BUILT	K.ASHBY

DRAWN	DESIGNED
M.PEPERE	I.DUNCAN
CHECKED K. RITSON	
APPROVED	
DATE	
K.ASHBY	

PROJECT
PRESTONS SOUTH
TITLE
PRESTONS SOUTH - STAGE 1 VACUUM SEWER AS BUILT LAYOUT PLAN SHEET 3 OF 3

AS BUILT	
PROJECT No. 235361	
SCALE 1:500	SIZE A1
DRAWING No. AB-PS-S1-VS-03	REV 1