




This AS BUILT drawing has been prepared based on Information provided by the contractor and confirmed by Aurecon.

**SHEET LAYOUT:**

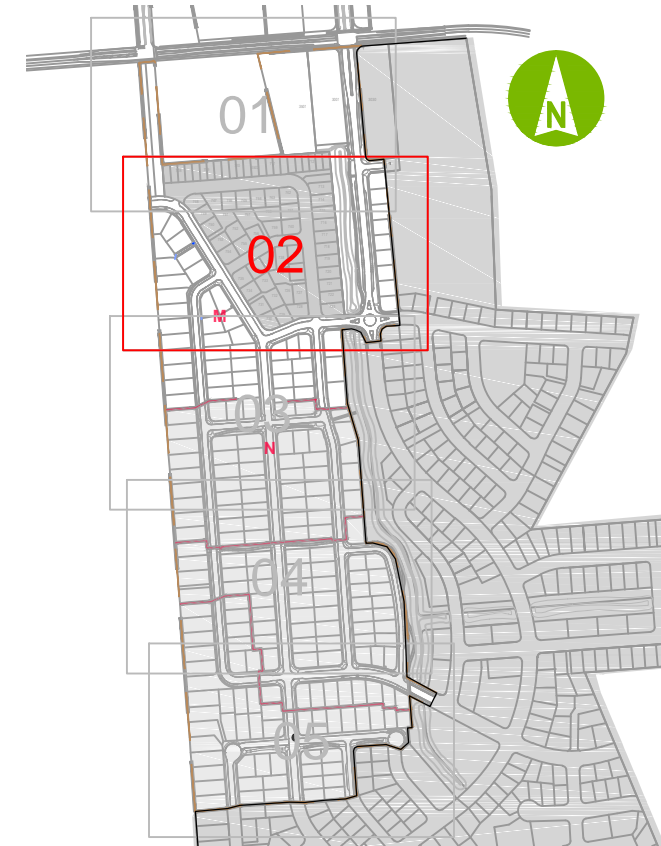

**LEGEND:**

- STAGE BOUNDARY
- SUB-STAGE BOUNDARIES
- uPVC PN12 PRESSURE MAIN
- MDPE 63 OD PN 12.5 SUBMAIN
- HYDRANT
- SLUISE VALVE ON PRESSURE MAIN
- GATE VALVE ON SUBMAIN
- DUMMY WATER METER
- DEAD END CAP
- THRUST BLOCK

5 0 10 20m  
SCALE 1:500



CLIENT		REV		DATE	REVISION DETAILS	APPROVED	DRAWN	DESIGNED	PROJECT		AS BUILT	
							M.PEPERE	I.DUNCAN	PRESTONS SOUTH		PROJECT No. 235361	
							CHECKED K. RISTON		TITLE		SCALE 1:500	SIZE A1
							APPROVED		PRESTONS SOUTH - STAGE 1 WATER RETICULATION AS BUILT LAYOUT PLAN SHEET 2 OF 3		DRAWING No. AB-PS-S1-WP-02	REV 2
		2	04/09/15		AS BUILT CCC AMENDMENTS	K.ASHBY	DATE 08/08/15					
		1	08/08/15		AS BUILT	K.ASHBY	K.ASHBY					