


This AS BUILT drawing has been prepared based on Information provided by the contractor and confirmed by Aurecon.

SHEET LAYOUT:

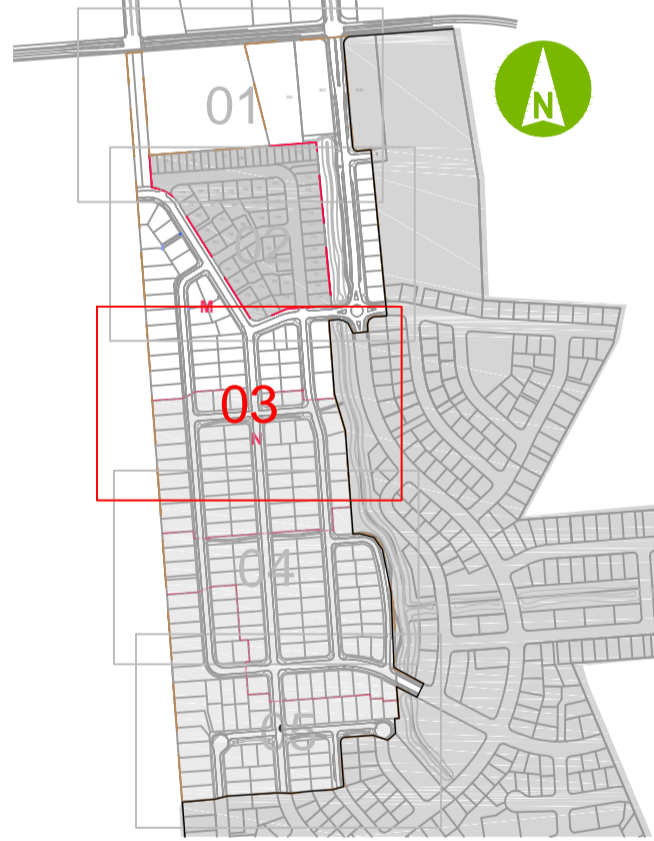

- LEGEND:**
- STAGE BOUNDARY
 - SUB-STAGE BOUNDARIES
 - uPVC PN12 PRESSURE MAIN
 - MDPE 63 OD PN 12.5 SUBMAIN
 - HYDRANT
 - SLUICE VALVE ON PRESSURE MAIN
 - GATE VALVE ON SUBMAIN
 - DUMMY WATER METER
 - DEAD END CAP
 - THRUST BLOCK



REV	DATE	REVISION DETAILS	APPROVED
1	08/08/15	AS BUILT	K.ASHBY

DRAWN	DESIGNED
M.PEPERE	I.DUNCAN
CHECKED	
S.HUSBAND	
APPROVED	
	DATE 08/08/15
K.ASHBY	

PROJECT
PRESTONS SOUTH
TITLE
PRESTONS SOUTH - STAGE 1 WATER RETICULATION AS BUILT LAYOUT PLAN SHEET 3 OF 3

AS BUILT
PROJECT No. 235361
SCALE 1:500
DRAWING No. AB-PS-S1-WP-03
SIZE A1
REV 1