





NOTES:

AS BUILT INFORMATION HAS BEEN SUPPLIED BY KBs CONTRACTING & QUARRIES LTD - SEPTEMBER 2015.
 HEIGHTS ARE IN TERMS OF MEAN SEA LEVEL
 ALL LATERALS ARE 100mmØ uPVC SN16

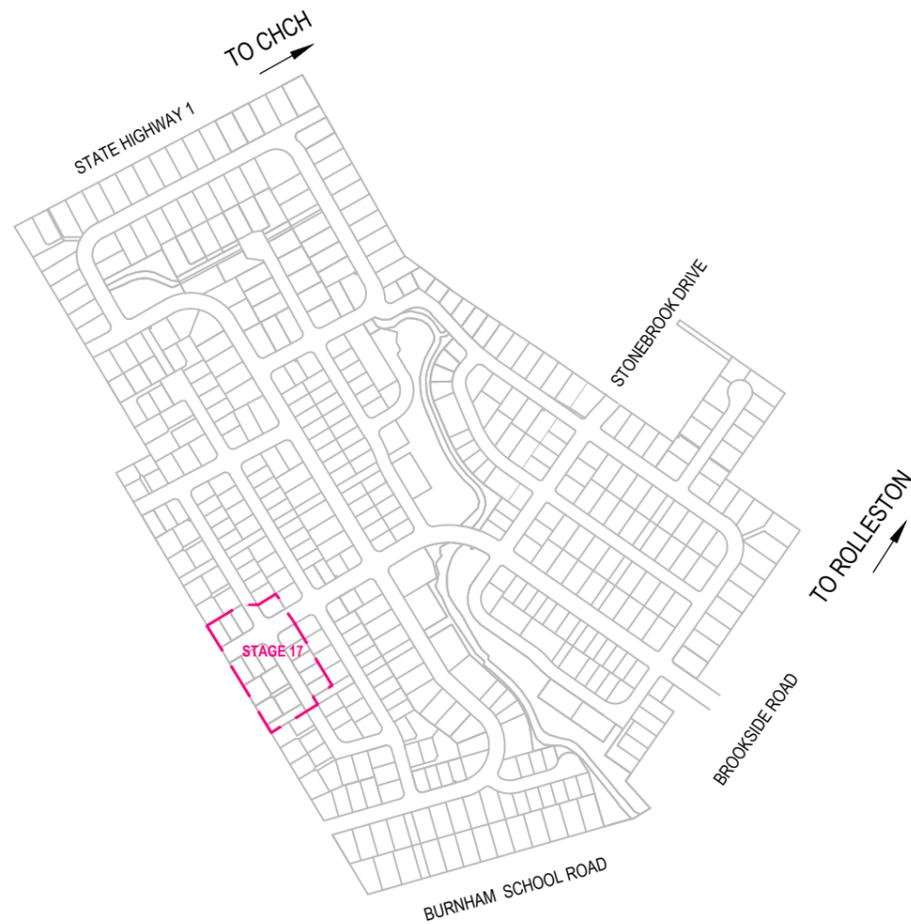

LOCATION PLAN

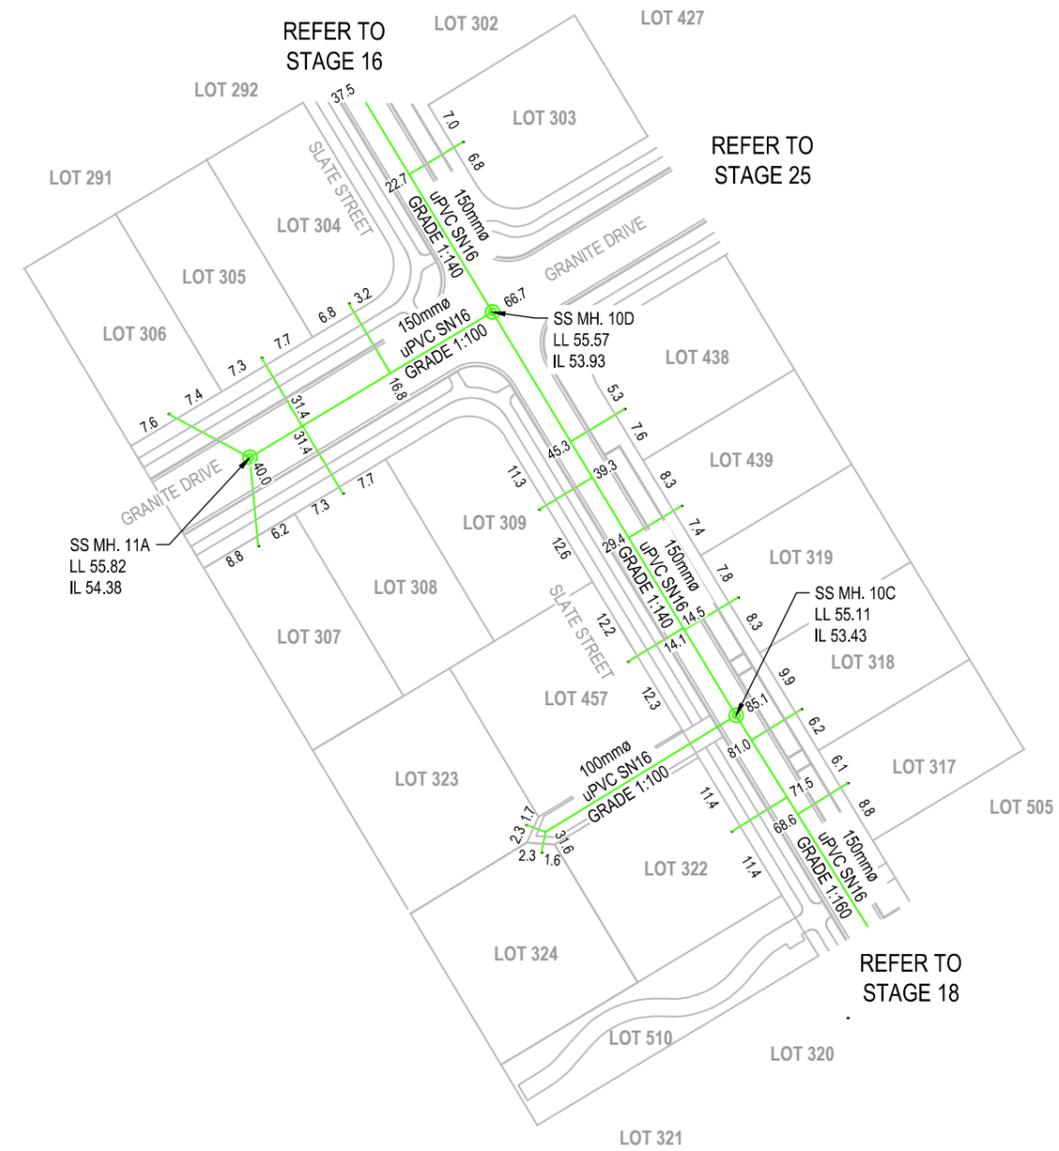

000000



CLIENT		REV	DATE	REVISION DETAILS	APPROVED	DRAWN	DESIGNED	PROJECT	
						A.COLUMBUS	M.CROWE	STONEBROOK ROLLESTON	
						CHECKED		TITLE	
						D.WATSON		STAGE 17	
						APPROVED		SEWER	
						B.TOMS	DATE	AS BUILT	
							25.09.15		
B	27.11.15			LOT NUMBER AMENDED	B.TOMS			SCALE	
A	25.09.15			AS BUILTS ISSUED	B.TOMS			AS SHOWN	
								DRAWING No.	
								224926	
								SIZE	
								A3	
								REV	
								B	

AS BUILT	
PROJECT No.	224926
SCALE	A3
AS SHOWN	
DRAWING No.	DW-LD-S17-AB-SS-01
REV	B