



NOTES:
 AS BUILT INFORMATION HAS BEEN SUPPLIED BY KBs
 CONTRACTING & QUARRIES LTD - SEPTEMBER 2015.
 HEIGHTS ARE IN TERMS OF MEAN SEA LEVEL
 ALL LATERALS ARE 20mmØ ID POLY

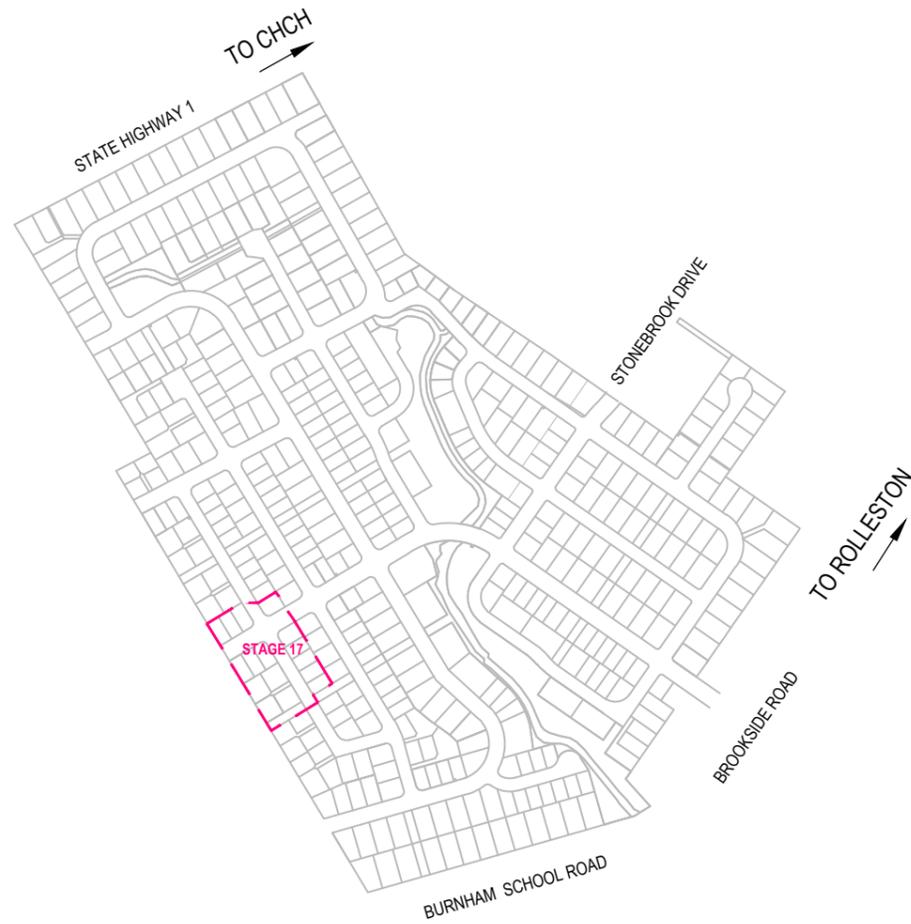

LOCATION PLAN

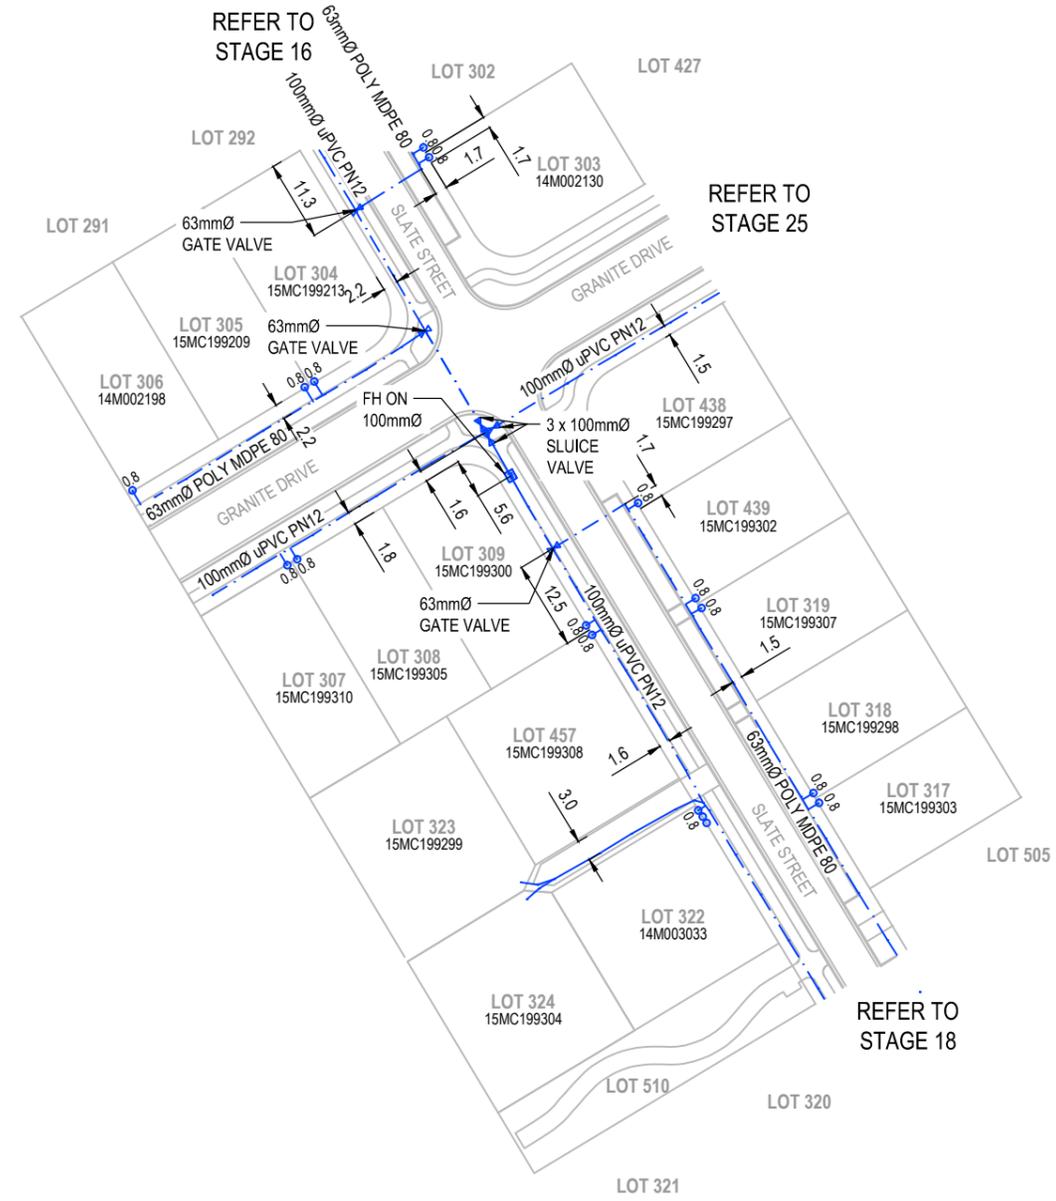

| REV | DATE | REVISION DETAILS | APPROVED |
|-----|----------|-------------------|----------|
| B | 27.11.15 | LOT NUMBER AMENED | B.TOMS |
| A | 25.09.15 | AS BUILTS ISSUED | B.TOMS |

| APPROVED | DRAWN | DESIGNED |
|----------|---------------|---------------|
| | A.COLUMBUS | M.CROWE |
| | CHECKED | |
| | D.WATSON | |
| | APPROVED | |
| | B.TOMS | DATE 25.09.15 |
| | B.TOMS | |

| PROJECT |
|-------------------------------|
| STONEBROOK ROLLESTON |
| TITLE |
| STAGE 17 WATER AS BUILT |

| | |
|-------------|-------------------|
| AS BUILT | |
| PROJECT No. | 224926 |
| SCALE | A3 |
| AS SHOWN | |
| DRAWING No. | DW-LD-S17-AB-W-01 |
| REV | B |