



PRESTONS ROAD

CONNECTED TO EXISTING MAIN

CONNECTED TO EXISTING MAIN

3001

3030


3501

ROAD P1


ROAD T6

This AS BUILT drawing has been prepared based on information provided by the contractor.

SHEET LAYOUT:

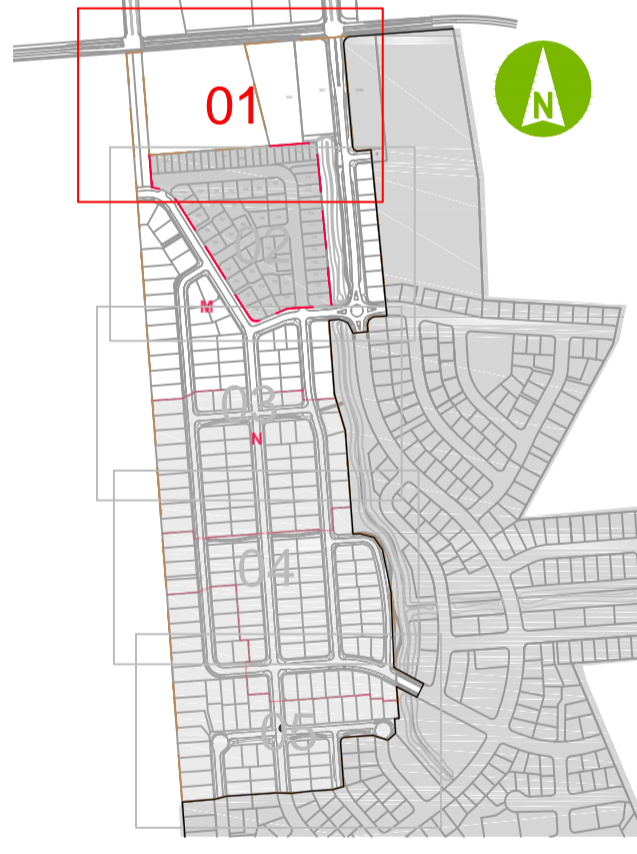

- LEGEND:**
- STAGE BOUNDARY
 - SUB-STAGE BOUNDARIES
 - uPVC PN12 PRESSURE MAIN
 - MDPE 63 OD PN 12.5 SUBMAIN
 - HYDRANT
 - SLUICE VALVE ON PRESSURE MAIN
 - GATE VALVE ON SUBMAIN
 - DUMMY WATER METER
 - DEAD END CAP
 - THRUST BLOCK

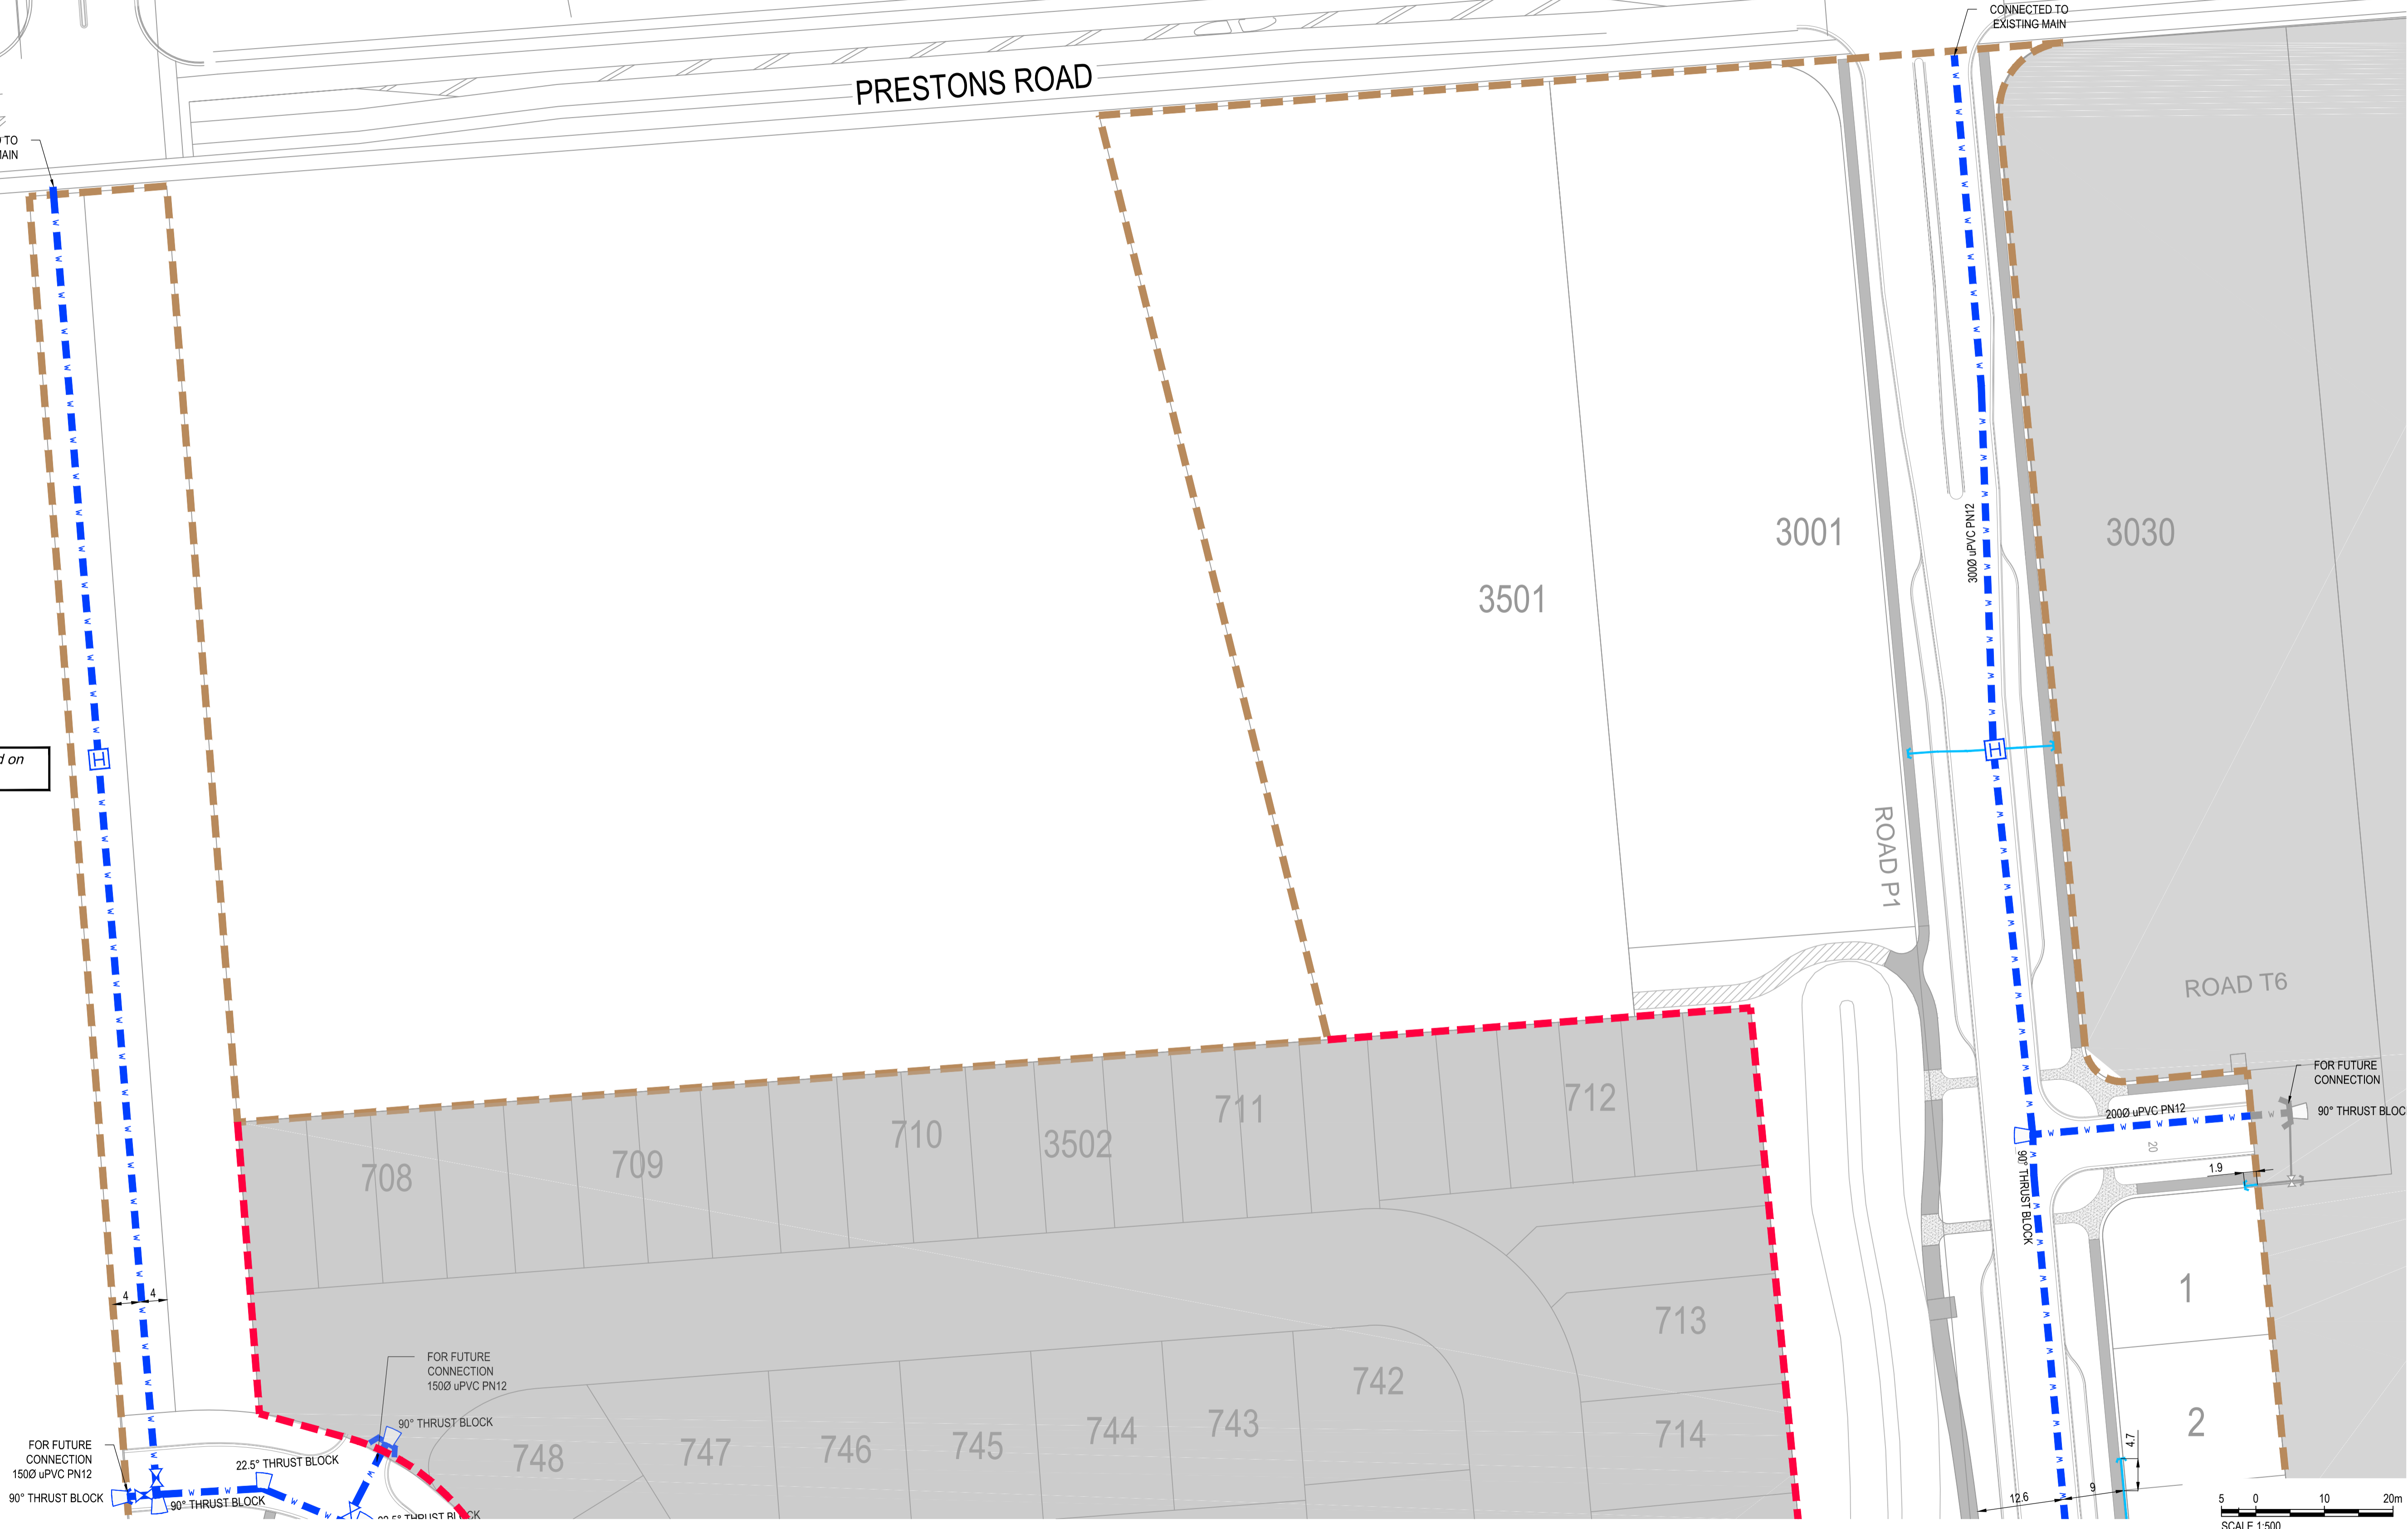

FOR FUTURE CONNECTION 1500 uPVC PN12

FOR FUTURE CONNECTION 1500 uPVC PN12

2000 uPVC PN12

FOR FUTURE CONNECTION 90° THRUST BLOC

SCALE 1:500



CLIENT



REV	DATE	REVISION DETAILS
1	08/08/15	AS BUILT

APPROVED	DRAWN	DESIGNED
K.ASHBY	M.PEPERE	I.DUNCAN
	CHECKED	
	K.RISTON	
	APPROVED	
		DATE 08/08/15
	K.ASHBY	

PROJECT
PRESTONS SOUTH
TITLE
PRESTONS SOUTH - STAGE 1 WATER RETICULATION AS BUILT LAYOUT PLAN SHEET 1 OF 3

AS BUILT
PROJECT No. 235361
SCALE 1:500
DRAWING No. AB-PS-S1-WP-01
SIZE A1
REV 1