




This AS BUILT drawing has been prepared based on information provided by the contractor.

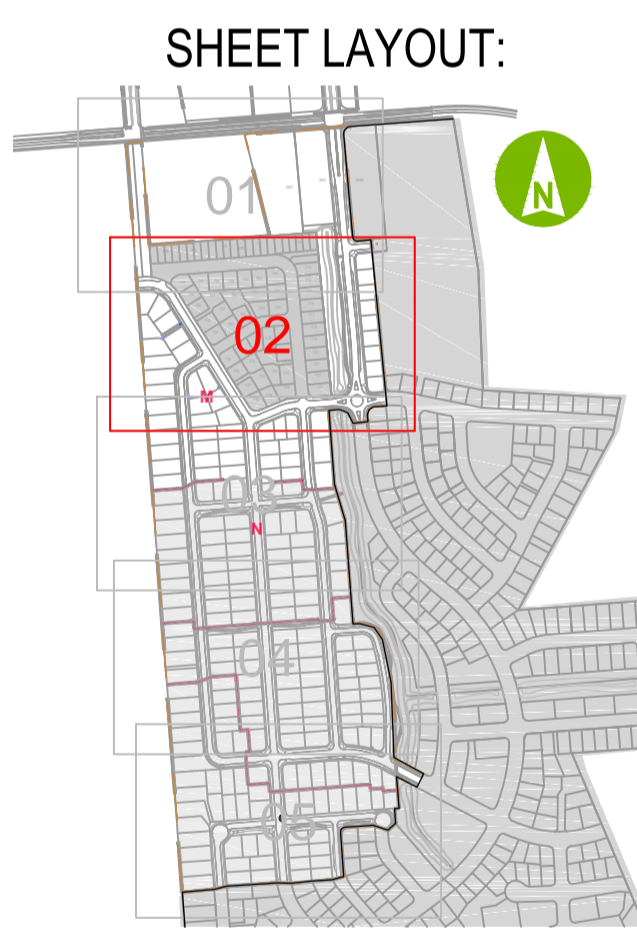

- LEGEND:**
- STAGE BOUNDARY
  - SUB-STAGE BOUNDARIES
  - uPVC PN12 PRESSURE MAIN
  - MDPE 63 OD PN 12.5 SUBMAIN
  - HYDRANT
  - SLUICE VALVE ON PRESSURE MAIN
  - GATE VALVE ON SUBMAIN
  - DUMMY WATER METER
  - DEAD END CAP
  - THRUST BLOCK

5 0 10 20m  
SCALE 1:500

**aurecon**  
www.aurecongroup.com



CLIENT		REV	DATE	REVISION DETAILS	APPROVED	DRAWN	DESIGNED	PROJECT	
						M.PEPERE	I.DUNCAN	PRESTONS SOUTH	
						CHECKED K. RISTON		TITLE	
						APPROVED		PRESTONS SOUTH - STAGE 1	
							DATE 08/08/15	WATER RETICULATION AS BUILT LAYOUT PLAN	
		1	08/08/15	AS BUILT	K.ASHBY	K.ASHBY		SHEET 2 OF 3	
								AS BUILT	
								PROJECT No. 235361	
								SCALE 1:500	SIZE A1
								DRAWING No. AB-PS-S1-WP-02	REV 1