


This AS BUILT drawing has been prepared based on information provided by the contractor.

SHEET LAYOUT:

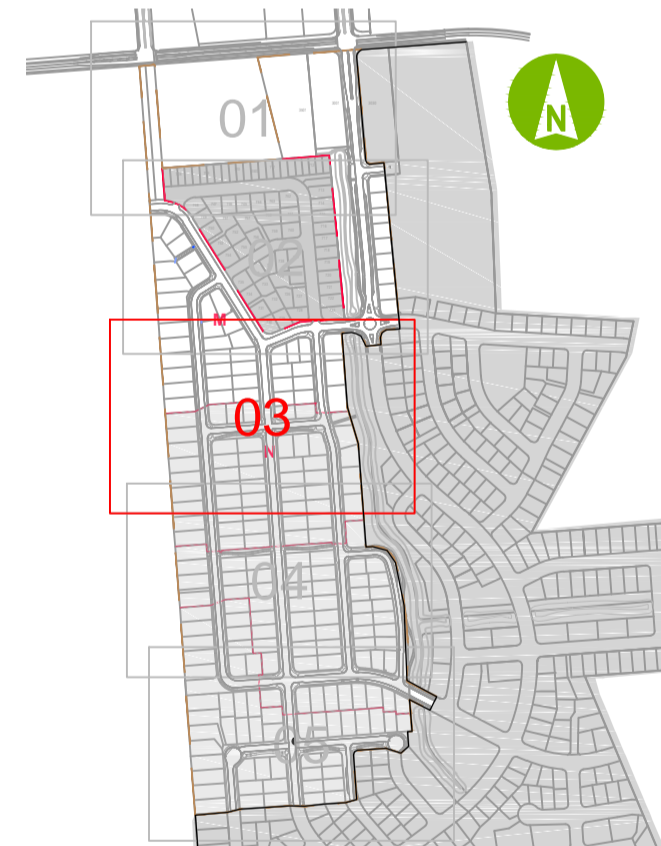

LEGEND:

- STAGE BOUNDARY
- SUB-STAGE BOUNDARIES
- uPVC PN12 PRESSURE MAIN
- MDPE 63 OD PN 12.5 SUBMAIN
- HYDRANT
- SLUICE VALVE ON PRESSURE MAIN
- GATE VALVE ON SUBMAIN
- DUMMY WATER METER
- DEAD END CAP
- THRUST BLOCK



www.aurecongroup.com



CLIENT

REV	DATE	REVISION DETAILS	APPROVED
1	08/08/15	AS BUILT	K.ASHBY

DRAWN	DESIGNED
M PEPERE	I.DUNCAN
CHECKED	
K. RISTON	
APPROVED	
	DATE 08/08/15
K.ASHBY	

PROJECT
PRESTONS SOUTH
TITLE
PRESTONS SOUTH - STAGE 1 WATER RETICULATION AS BUILT LAYOUT PLAN SHEET 3 OF 3

AS BUILT	
PROJECT No.	235361
SCALE	1:500
SIZE	A1
DRAWING No.	AB-PS-S1-WP-03
REV	1