


STAGE 2

- LEGEND**
- SUB-STAGE N BOUNDARY
 - PROPOSED TREE
 - STREETLIGHT
 - DOUBLE SUMP
 - SINGLE SUMP
 - CORNER SUMP
 - SW TO KERB
 - POWER KIOSK
 - SWALE DRAIN
 - EASEMENT

SURVEY ORIGIN DATA

- THE PROPERTY DATA HAS BEEN SOURCED FROM AURECON (DECEMBER 2015) AND IS SUBJECT TO FINAL LEGAL REVIEW BY LAND INFORMATION NEW ZEALAND (LINZ).
- VERTICAL ELEVATIONS ARE IN TERMS OF CHRISTCHURCH DRAINAGE DATUM, SCIRT PUBLISHED JUNE 2011.
- THE ORIGIN OF LEVELS IS BM 3257 (EHDK), RL 15.160m

NOTES:
KERB LEVELS ARE AT TOP OF KERB.
TREES & LANDSCAPING ARE INDICATIVE ONLY

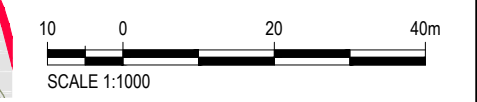

REV	DATE	REVISION DETAILS	APPROVED
B	02/03/16	AS-BUILT STORMWATER LATERALS	K ASHBY
A	18/01/16	ISSUED FOR INFORMATION	K ASHBY

DRAWN R DAWSON	DESIGNED L MORGAN
CHECKED K ASHBY	APPROVED
K ASHBY	
DATE 18/01/16	

PROJECT PRESTONS PARK
TITLE SITE LEVELS SUB-STAGE N STAGE 1

INFORMATION	
PROJECT No.	235361
SCALE	1:1000
SIZE	A3
DRAWING No.	SU-PS-S1-IN-14
REV	B