


- LEGEND:**
- STORMWATER MAIN
 - STORMWATER LATERAL
 - STORMWATER MANHOLE (STANDARD)
 - STORMWATER MANHOLE (C.C.C. SD303)
 - DOUBLE SUMP
 - SINGLE SUMP
 - CORNER SUMP TO BUBBLE UP
 - DOUBLE CORNER SUMP
 - STORMWATER SUMP LEAD
 - STAGE BOUNDARY
 - SUB-STAGE BOUNDARY

- NOTES:**
- ALL SUMP LEADS FROM SINGLE SUMPS ARE 2250 OR 3000 FROM DOUBLE SUMPS UNLESS OTHERWISE STATED.
 - REFER TO DRAWINGS AB-PN-S1-SL-04-05 FOR STORMWATER LONGSECTIONS.
 - ALL STORMWATER HOUSE CONNECTIONS ARE 1000 PVC-U SN16.
- SURVEY ORIGIN DATA:**
 VERTICAL ELEVATIONS ARE IN TERMS OF CHRISTCHURCH DRAINAGE DATUM. SCRT PUBLISHED JUNE 2011.
 THE ORIGIN OF LEVELS IS BM 3257 (EHDK), RL 15.160m (POINT #378 ON PLAN FACE) LOCATED AT THE INTERSECTION OF APLINE VIEW LANE, WAITIKIRI DRIVE & LEN HALE PLACE.
 HORIZONTAL COORDINATES ARE IN TERMS OF NZ GEODETIC DATUM 2000.
 MOUNT PLEASANT 2000 CIRCUIT.

This AS BUILT drawing has been prepared based on information provided by the contractor.

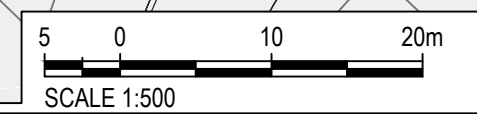

REV	DATE	REVISION DETAILS	APPROVED
2	22/01/16	AS BUILT	KASHBY
1	08/12/15	AS BUILT	KASHBY

DRAWN	DESIGNED
M. PEPERE	G. BAILEY
CHECKED	
J. WHITE	
APPROVED	
	DATE
	08/12/15

PROJECT
PRESTONS PARK
TITLE
PRESTONS SOUTH - STAGE 1 - SUBSTAGE N STORMWATER AS BUILT LAYOUT PLAN SHEET 1 OF 2

AS BUILT	
PROJECT No.	235361
SCALE	1:500
SIZE	A1
DRAWING No.	AB-PS-S1-SP-04
REV	2