


SHEET LAYOUT:

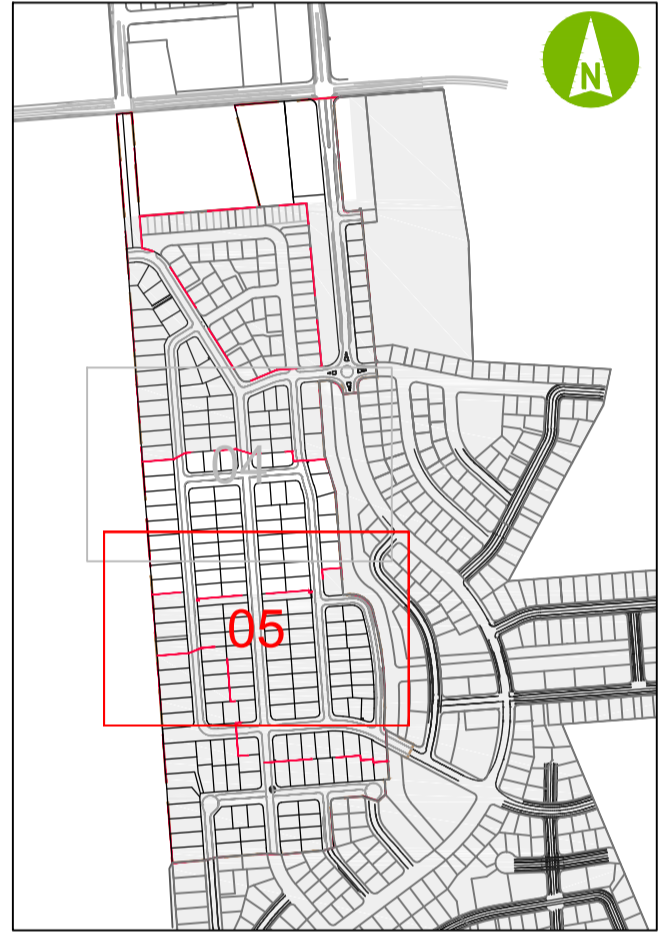

LEGEND:


- STORMWATER MAIN
- STORMWATER LATERAL
- STORMWATER MANHOLE (STANDARD)
- STORMWATER MANHOLE (C.C.C SD303)
- DOUBLE SUMP
- SINGLE SUMP
- CORNER SUMP TO BUBBLE UP
- DOUBLE CORNER SUMP
- STORMWATER SUMP LEAD
- STAGE BOUNDARY
- SUB-STAGE BOUNDARY

NOTES:

1. ALL SUMP LEADS FROM SINGLE SUMPS ARE 2250 OR 3000 FROM DOUBLE SUMPS UNLESS OTHERWISE STATED.
 2. REFER TO DRAWINGS AB-PN-S1-SL-04-05 FOR STORMWATER LONGSECTIONS.
 3. ALL STORMWATER HOUSE CONNECTIONS ARE 1000 PVC-U SN16.
- SURVEY ORIGIN DATA:**
 VERTICAL ELEVATIONS ARE IN TERMS OF CHRISTCHURCH DRAINAGE DATUM. SCIRT PUBLISHED JUNE 2011.
 THE ORIGIN OF LEVELS IS BM 3257 (EHDK), RL 15.160m (POINT #378 ON PLAN FACE) LOCATED AT THE INTERSECTION OF APLINE VIEW LANE, WAITIKIRI DRIVE & LEN HALE PLACE.
 HORIZONTAL COORDINATES ARE IN TERMS OF NZ GEODETIC DATUM 2000.
 MOUNT PLEASANT 2000 CIRCUIT.

This AS BUILT drawing has been prepared based on information provided by the contractor.

Asset ID	mN	mE	Asset Description
1	812328.4	395143.7	MH1050
2	812330.5	395141.9	SINGLE SUMP
3	812331.1	395149.2	SINGLE SUMP
4	812334.4	395232.5	MH1050
5	812335.3	395226	SINGLE SUMP
6	812336	395234.8	SINGLE SUMP
7	812402.5	395305.1	SINGLE SUMP
8	812403	395312.4	SINGLE SUMP
9	812405.5	395306.5	MH1050
10	812422.1	395134.6	DOUBLE SUMP
11	812422.5	395142	SINGLE SUMP
12	812424.3	395136.1	MH1050
13	812425.3	395219.3	SINGLE SUMP
14	812426	395228.1	SINGLE SUMP
15	812428.8	395225.3	MH1050
16	812436.2	395302.4	SINGLE SUMP
17	812436.8	395309.7	SINGLE SUMP
18	812438.9	395304.1	MH1050
19	812447	395089.1	DOUBLE SUMP
20	812450.4	395134	MH1050
21	812459.4	395147.1	SINGLE SUMP
22	812460.1	395131.6	DOUBLE SUMP
23	812460.1	395133.2	MH1200SQ
24	812460.7	395146.9	MH1200SQ
25	812464.4	395214	SINGLE SUMP
26	812466.1	395213.8	MH1200SQ
27	812466.7	395146.6	SINGLE SUMP
28	812466.7	395222.8	MH1200SQ
29	812469.9	395287	DOUBLE SUMP
30	812471.7	395213.6	SINGLE SUMP
31	812472.1	395293.6	MH1200SQ
32	812475.4	395215.5	DOUBLE SUMP
33	812476.1	395299.1	DOUBLE SUMP
34	812476.2	395224.4	DOUBLE SUMP
35	812476.9	395282.7	DOUBLE SUMP
36	812484.4	395342.8	OUTLET

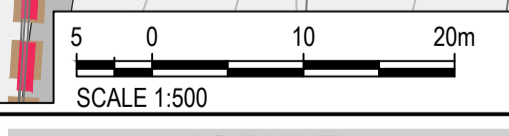

REV	DATE	REVISION DETAILS	APPROVED
2	22/01/16	AS BUILT	KASHBY
1	09/12/15	AS BUILT	KASHBY

DRAWN	DESIGNED
M. PEPERE	G. BAILEY
CHECKED	
J. WHITE	
APPROVED	
DATE	

PROJECT
PRESTONS PARK
TITLE
PRESTONS SOUTH - STAGE 1 - SUBSTAGE N STORMWATER AS BUILT LAYOUT PLAN SHEET 2 OF 2

AS BUILT
PROJECT No. 235361
SCALE 1:500
DRAWING No. AB-PS-S1-SP-05
SIZE A1
REV 2