



SHEET LAYOUT:



LEGEND:


- STORMWATER MAIN
- STORMWATER LATERAL
- STORMWATER MANHOLE (STANDARD)
- STORMWATER MANHOLE (C.C.C SD303)
- DOUBLE SUMP
- SINGLE SUMP
- CORNER SUMP TO BUBBLE UP
- DOUBLE CORNER SUMP
- STORMWATER SUMP LEAD
- - - STAGE BOUNDARY
- - - SUB-STAGE BOUNDARY

NOTES:

1. ALL SUMP LEADS ARE 2250 UNLESS OTHERWISE STATED.
2. REFER TO DRAWINGS AB-PN-S1-SL-04-05 FOR STORMWATER LONGSECTIONS.
3. ALL STORMWATER HOUSE CONNECTIONS ARE 1000 PVC-U SN16.

SURVEY ORIGIN DATA:
 VERTICAL ELEVATIONS ARE IN TERMS OF CHRISTCHURCH DRAINAGE DATUM. SCIRT PUBLISHED JUNE 2011.
 THE ORIGIN OF LEVELS IS BM 3257 (EHDK) RL 15.160m (POINT #379 ON PLAN FACE) LOCATED AT THE INTERSECTION OF APLINE VIEW LANE, WAITIKIRI DRIVE & LEN HALE PLACE.
 HORIZONTAL COORDINATES ARE IN TERMS OF NZ GEODETIC DATUM 2000.
 MOUNT PLEASANT 2000 CIRCUIT.

This AS BUILT drawing has been prepared based on information provided by the contractor.

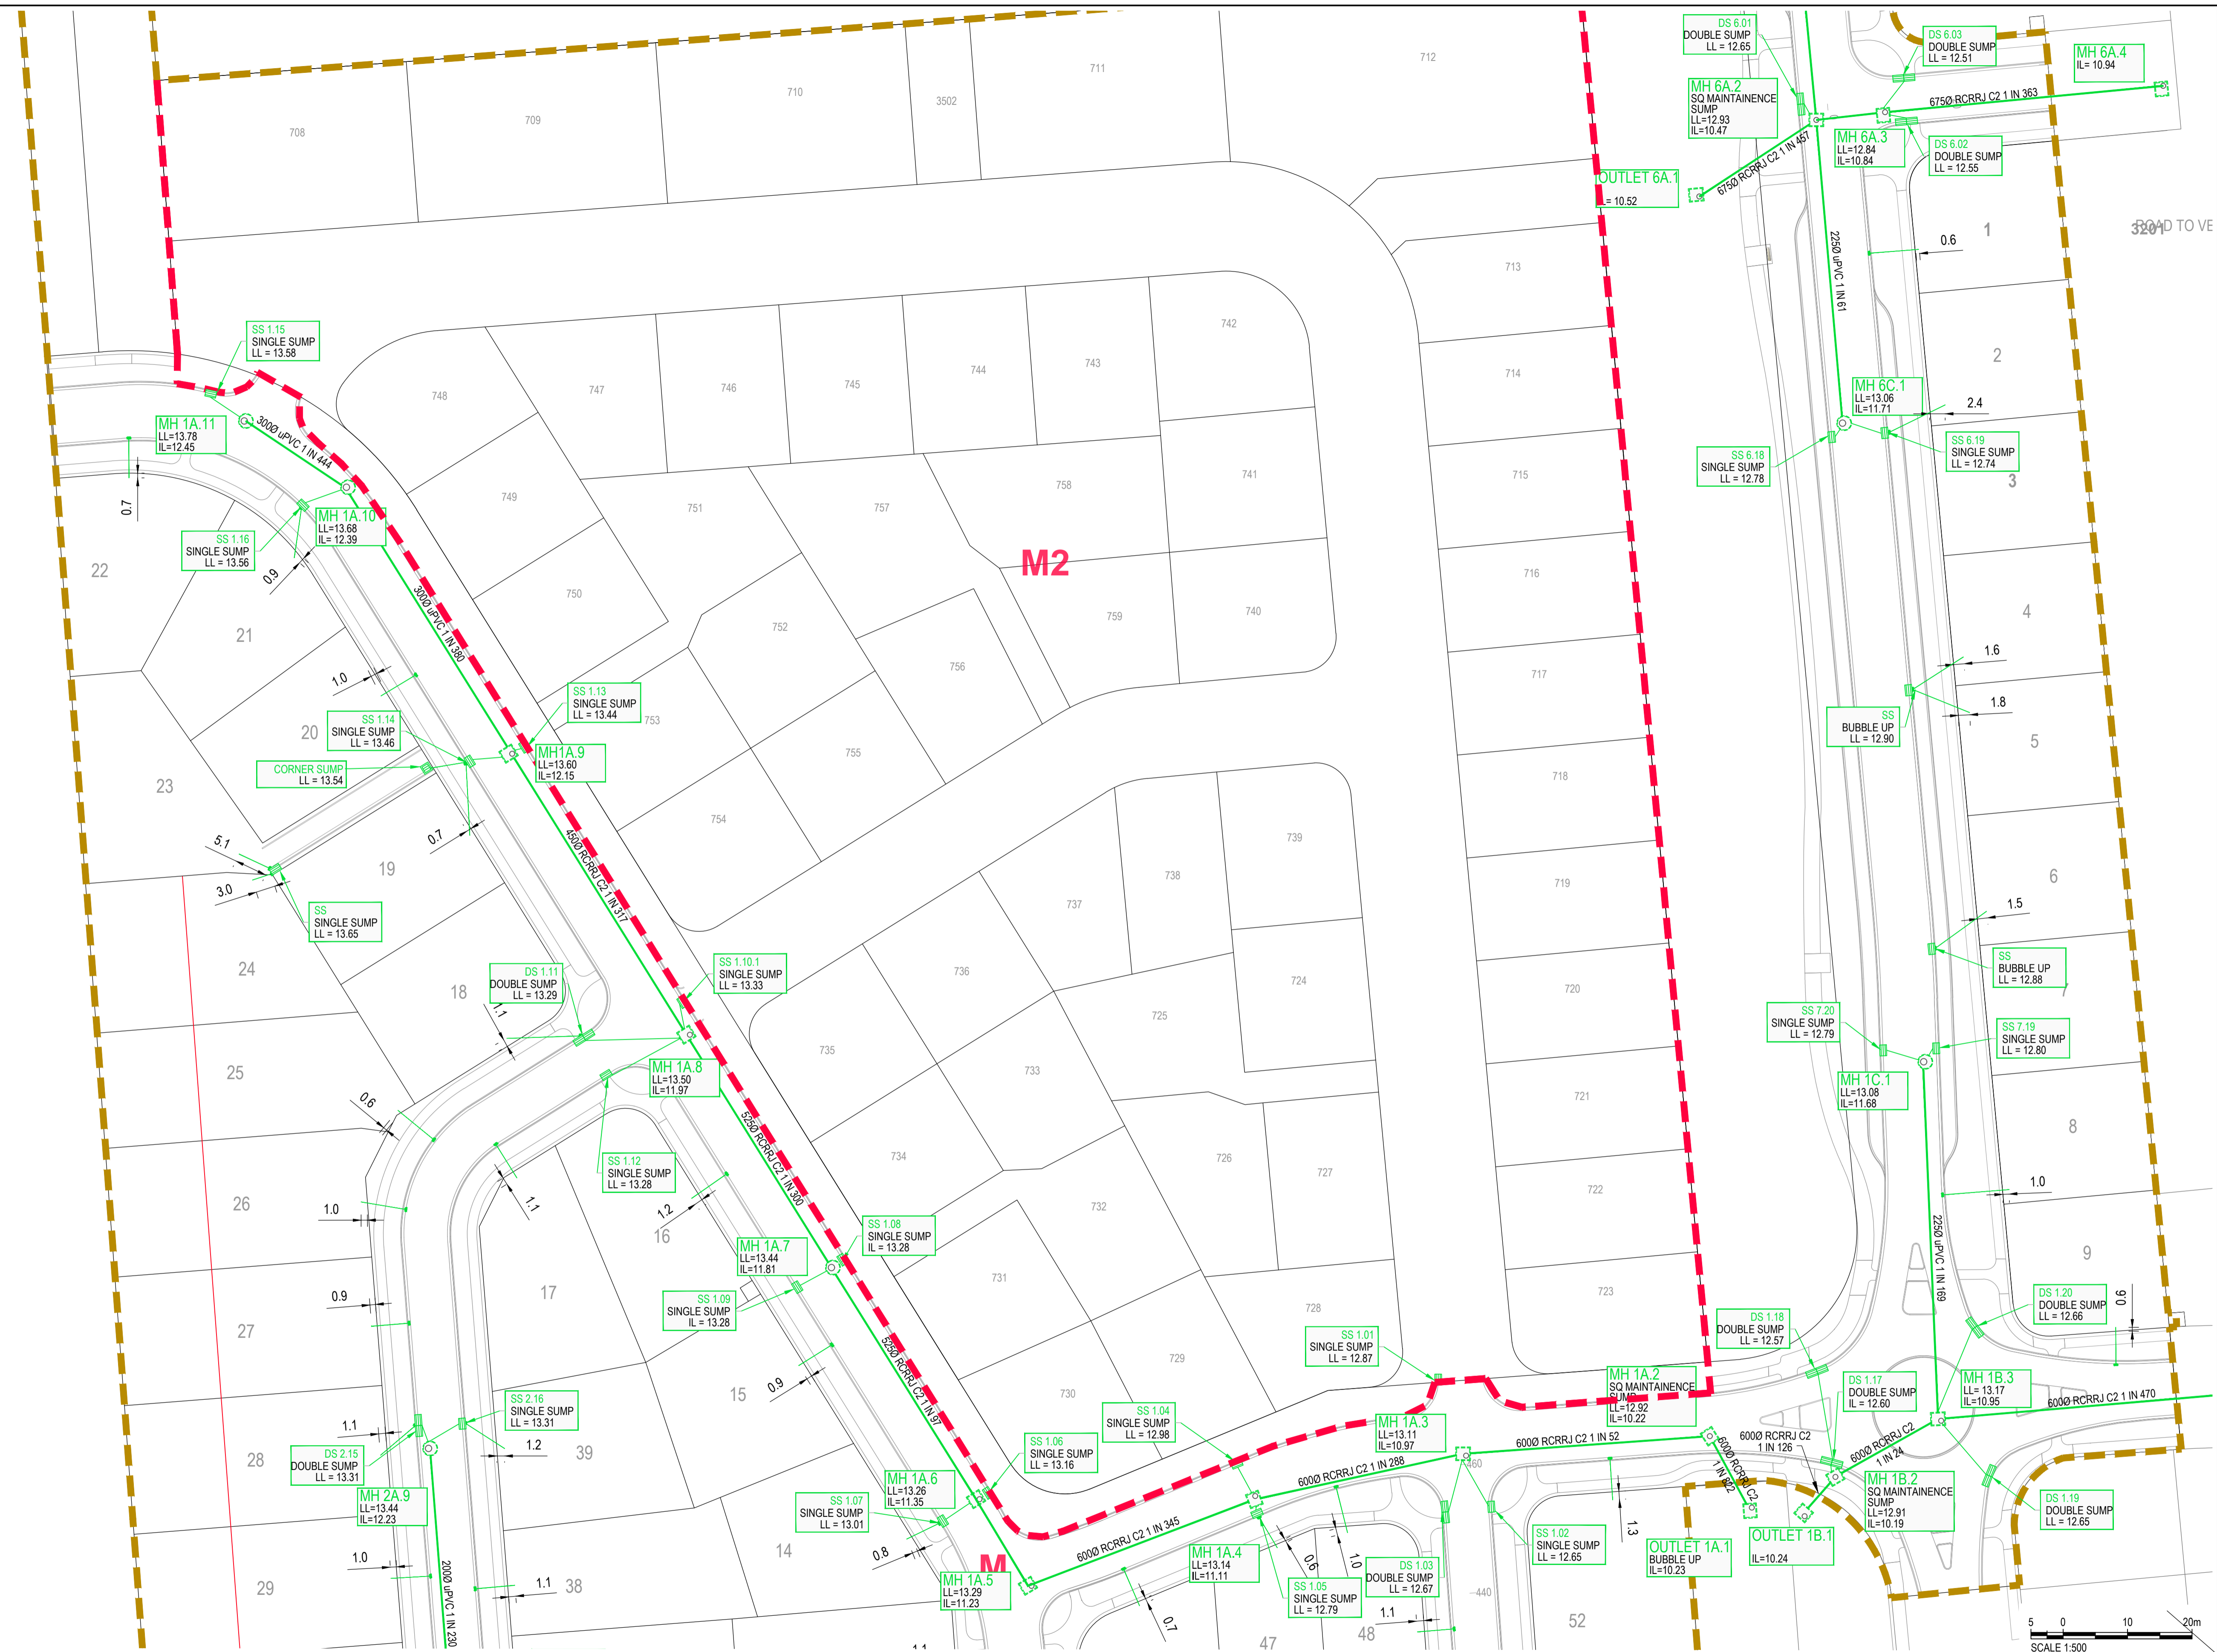

REV	DATE	REVISION DETAILS	APPROVED
4	22/06/16	LOT 27 LATERAL	K ASHBY
3	10/09/15	AS BUILT SUMP ADDED	K ASHBY
2	04/09/15	AS BUILT CCC AMENDMENTS	K ASHBY
1	08/08/15	AS BUILT	K ASHBY

APPROVED	DRAWN	DESIGNED
	M. PEPERE	I. DUNCAN
	CHECKED	
	J. WHITE	
	APPROVED	
	K. ASHBY	
		DATE 08/08/15

PROJECT	TITLE
PRESTONS PARK	PRESTONS SOUTH - STAGE 1 - SUBSTAGE M
	STORMWATER AS BUILT LAYOUT PLAN
	SHEET 2 OF 3

AS BUILT	SIZE
PROJECT No.	A1
235361	
SCALE	REV
1:500	4
DRAWING No.	
AB-PS-S1-SP-02	