


SUBJECT TO FINAL COUNCIL APPROVAL

SHEET LAYOUT:

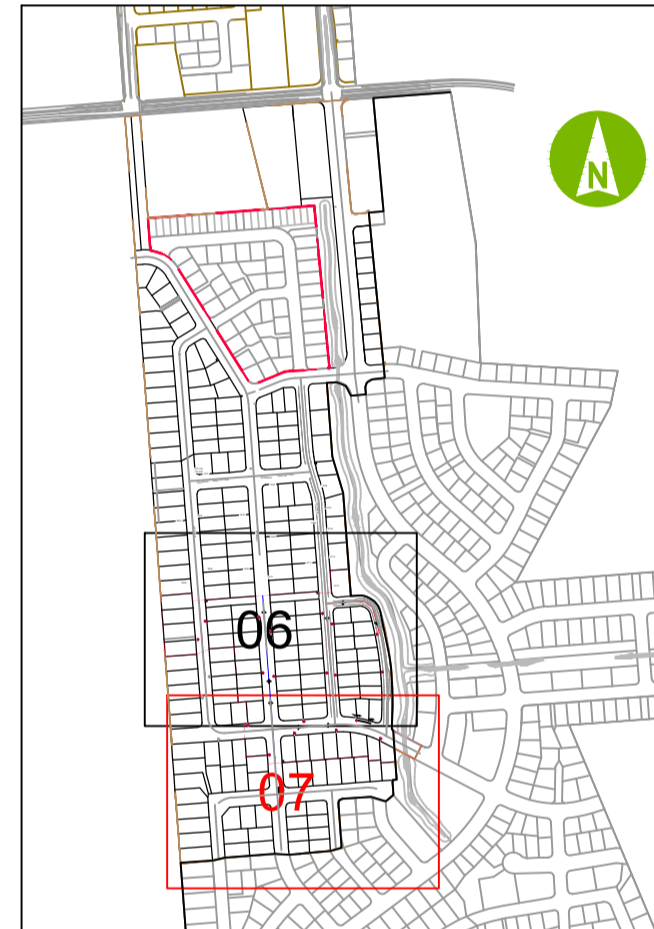

LEGEND:

- STAGE BOUNDARY
- STAGE O BOUNDARIES
- VACUUM MAINS PE100 PN12.5 SDR13.6
 - 900D
 - 1250D
 - 1600D
 - 2000D
 - 2500D
 - 2800D
- FLOVAC VACUUM INTERFACE VALVE
- ECCENTRIC REDUCER
- DIVISION VALVE
- MAINTENANCE RISER
- VACUUM SEWER VENT INTAKE PILLAR
- CONCRETE CAPPING
- LIFT

This AS BUILT drawing has been prepared based on information provided by the contractor.

Asset ID	Easting	Northing	Asset Type
1	395155.9	812276.1	VB-10
2	395149.9	812276.7	VB-10 JUNCTION
3	395151.6	812253.9	VB-11 JUNCTION
4	395146.2	812252.0	VB-11
5	395227.2	812281.6	VA-11
6	395234.3	812283.4	VA-11 JUNCTION
7	395235.8	812262.3	VA-12 JUNCTION
8	395242.8	812261.6	VA-12
9	395232.6	812208.0	VA-13
10	395239.6	812209.4	VA-13 JUNCTION
11	395240.0	812203.4	VA-14 JUNCTION
12	395246.9	812203.0	VA-14
13	395219.7	812130.9	DIVISION VALVE
14	395248.3	812095.6	DIVISION VALVE
15	395268.6	812134.5	DIVISION VALVE
16	395319.8	812299.6	DIVISION VALVE
17	395387.2	812259.9	ECCENTRIC REDUCER
18	395322.8	812208.8	ECCENTRIC REDUCER
19	395355.4	812137.8	ECCENTRIC REDUCER
20	395214.1	812130.5	ECCENTRIC REDUCER
21	395245.6	812132.4	VAC MAIN 5-5 JUNCTION
22	395245.2	812134.6	VAC MAIN 5-6 JUNCTION
23	395316.3	812299.8	VAC MAIN 5-3.1 JUNCTION
24	395214.6	812130.5	VH-01 JUNCTION
25	395212.8	812138.2	VH-01
26	395241.1	812099.2	VA-15
27	395247.9	812100.1	VA-15 JUNCTION
28	395274.0	812128.0	VI-01
29	395272.8	812134.8	VI-01 JUNCTION
30	395286.3	812135.7	VI-02 JUNCTION
31	395286.6	812143.2	VI-02
32	395329.7	812132.0	VI-03
33	395328.7	812139.2	VI-03 JUNCTION
34	395383.4	812258.7	VG-01
35	395387.0	812260.5	VG-01 JUNCTION
36	395394.4	812211.4	VG-02 JUNCTION
37	395390.8	812208.8	VG-02



REV	DATE	REVISION DETAILS	APPROVED	DRAWN	DESIGNED	PROJECT	AS BUILT
				J.WARLICH-KOOLE	C.CHOW	PRESTONS PARK	PROJECT No. 235361
				CHECKED J.WHITE		TITLE	SCALE A1
				APPROVED K.ASHBY	DATE 10/08/16	PRESTONS SOUTH - STAGE 1 - SUBSTAGE O VACUUM SEWER AS BUILT LAYOUT PLAN SHEET 2 OF 2	DRAWING No. AB-PS-S1-VS-07
1	18/07/16	AS BUILT	K.ASHBY	K.ASHBY			REV 1