



**SHEET LAYOUT:**

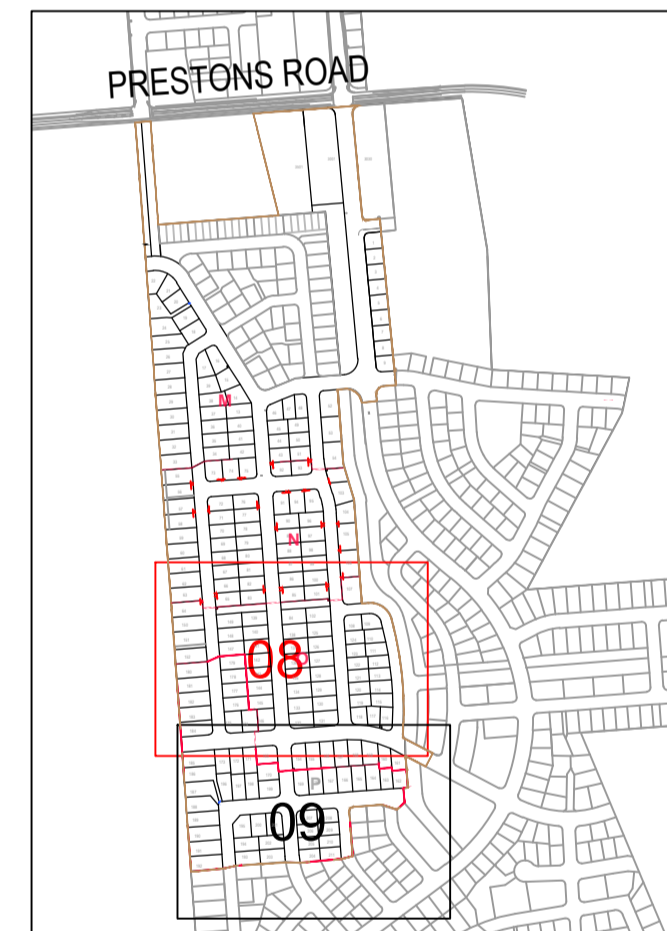

**LEGEND:**

- STAGE BOUNDARY
- STAGE O BOUNDARIES
- uPVC PN12 PRESSURE MAIN
- MDPE 630D PN1212.5 SUBMAIN
- HYDRANT
- SLUICE VALVE ON PRESSURE MAIN
- GATE VALVE ON SUBMAIN
- DUMMY WATER METER
- DEAD END CAP
- THRUST BLOCK

*This AS BUILT drawing has been prepared based on information provided by the contractor "KB Contracting".*

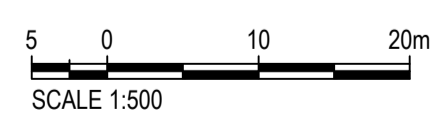

REV	DATE	REVISION DETAILS	APPROVED
2	07/11/16	AS BUILT	K.ASHBY
1	04/10/16	AS BUILT	K.ASHBY

DRAWN	DESIGNED
J.ANDRELL	J.ANDRELL
CHECKED J.TUCKER	
APPROVED K.ASHBY	
DATE 04/10/16	

PROJECT
PRESTONS PARK
TITLE
STAGE 1 - SUBSTAGE P WATER RETICULATION AS BUILT LAYOUT PLAN SHEET 1 OF 2

AS BUILT	
PROJECT No.	235361
SCALE AS SHOWN	A1
DRAWING No.	AB-PS-S1-WP-08
REV	2