




SHEET LAYOUT:

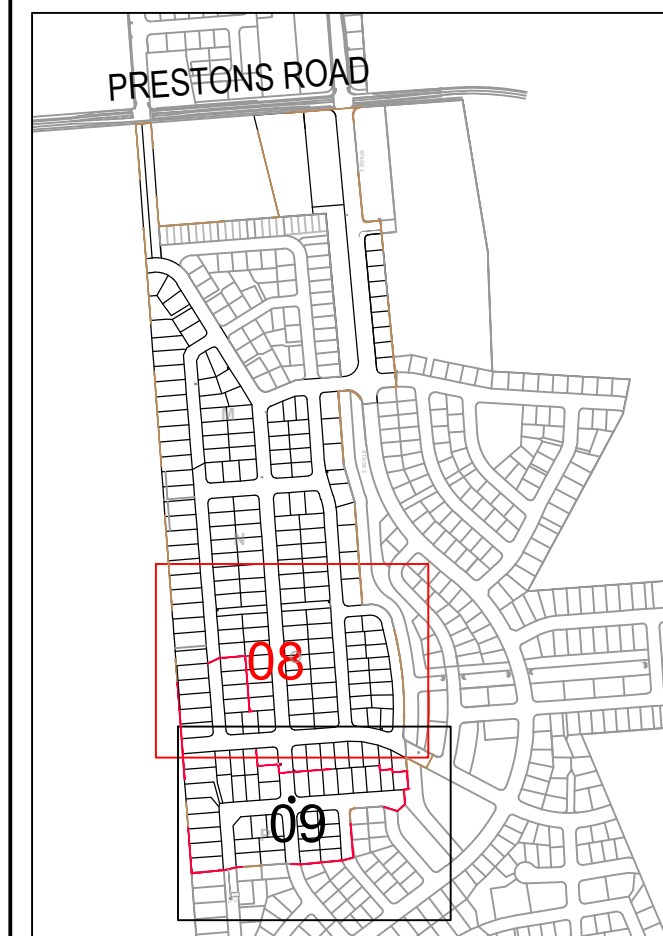

LEGEND:


- STORMWATER MAIN
- STORMWATER LATERAL
- STORMWATER MANHOLE (STANDARD)
- STORMWATER MANHOLE (C.C.C SD303)
- DOUBLE SUMP
- SINGLE SUMP
- CORNER SUMP TO BUBBLE UP
- DOUBLE CORNER SUMP
- STORMWATER SUMP LEAD
- STAGE BOUNDARY
- SUB-STAGE BOUNDARY

NOTES:

1. ALL SUMP LEADS ARE 225Ø UNLESS OTHERWISE STATED.
2. REFER TO DRAWINGS AB-PN-S1-SL-08-09 FOR STORMWATER LONGSECTIONS.
3. ALL STORMWATER HOUSE CONNECTIONS ARE 100Ø PVC-U SN16.

SURVEY ORIGIN DATA:
 VERTICAL ELEVATIONS ARE IN TERMS OF CHRISTCHURCH DRAINAGE DATUM. SCIRT PUBLISHED JUNE 2011.
 THE ORIGIN OF LEVELS IS BM 3257 (EHDK), RL 15.160m (POINT #378 ON PLAN FACE) LOCATED AT THE INTERSECTION OF APLINE VIEW LANE, WAITIKIRI DRIVE & LENHALE PLACE.
 HORIZONTAL COORDINATES ARE IN TERMS OF NZ GEODETIC DATUM 2000, MOUNT PLEASANT 2000 CIRCUIT.

This AS BUILT drawing has been prepared based on information provided by the contractor "KB Contracting".

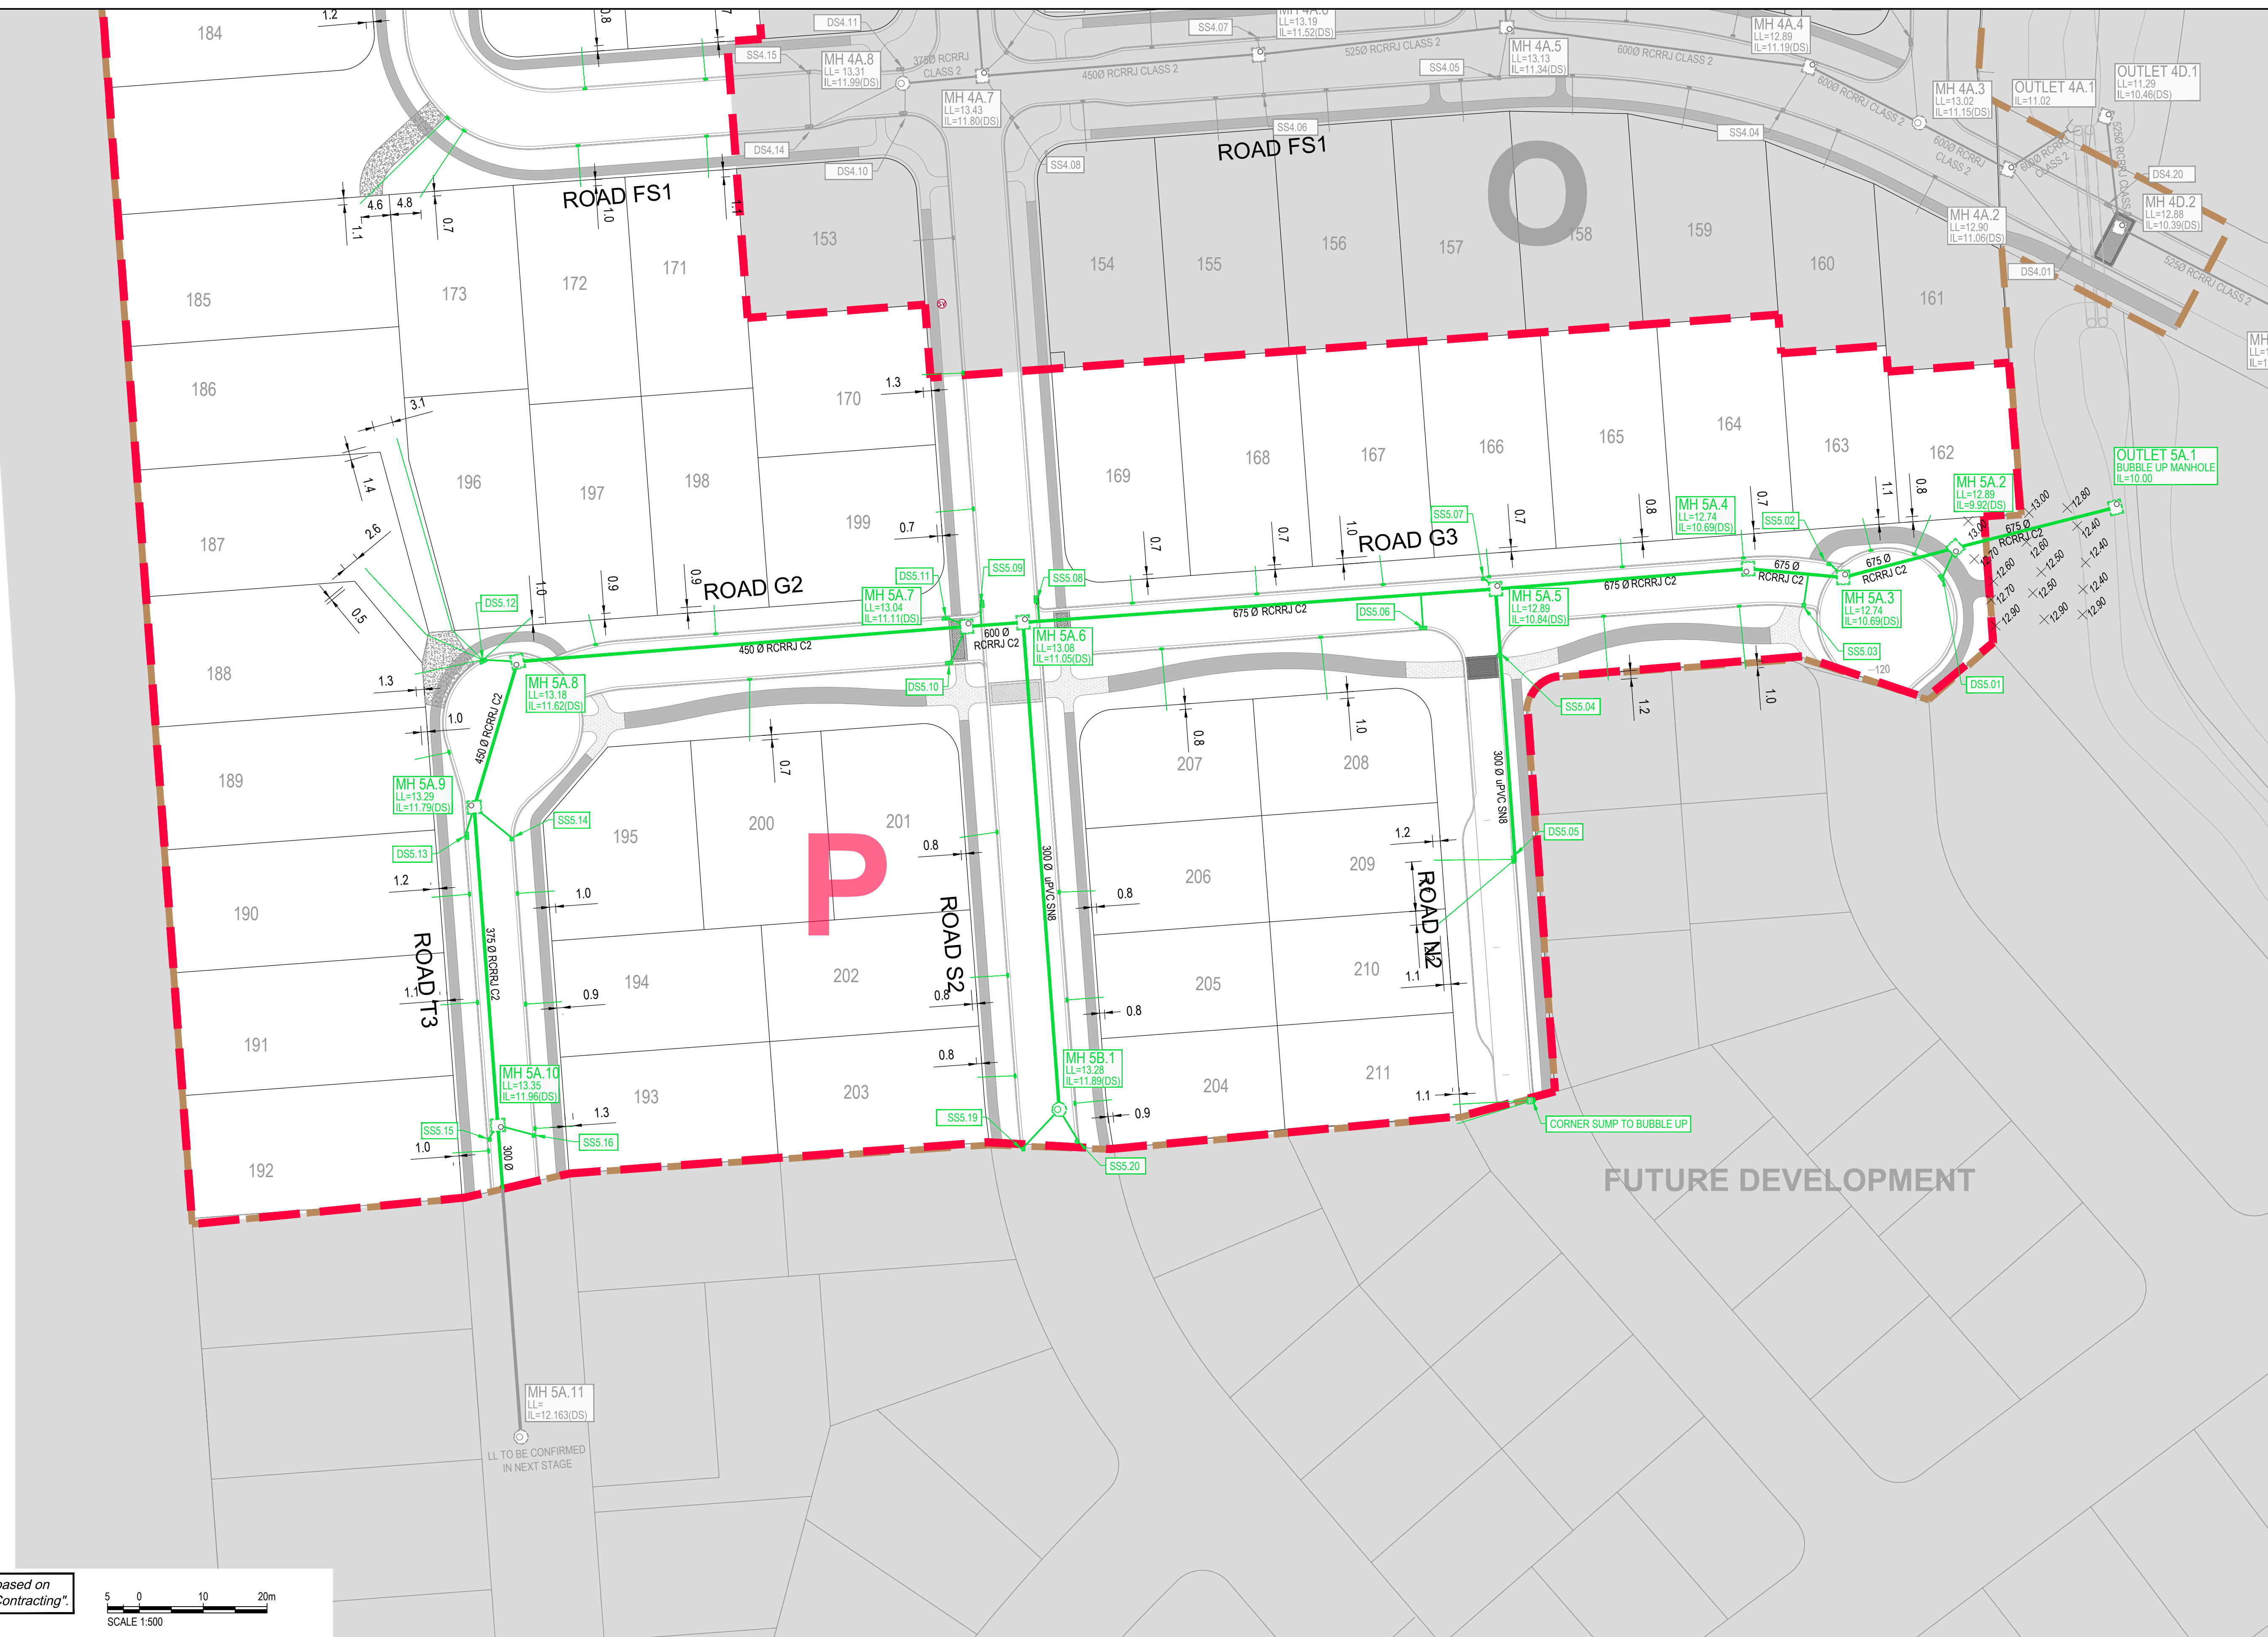

REV	DATE	REVISION DETAILS	APPROVED
3	23/11/16	AS BUILT	K ASHBY
2	17/11/16	AS BUILT	K ASHBY
1	04/11/16	AS BUILT	K ASHBY

DRAWN	DESIGNED
J.ANDRELL	J.ANDRELL
CHECKED J.TUCKER	
APPROVED K.ASHBY	
DATE 07/11/16	

PROJECT
PRESTONS PARK
TITLE
STAGE 1 - SUBSTAGE P STORMWATER AS BUILT LAYOUT PLAN SHEET 1 OF 2

AS BUILT	
PROJECT No.	235361
SCALE	AS SHOWN
AS SHOWN	A1
DRAWING No.	AB-PS-S1-SP-08
REV	3