




SHEET LAYOUT:

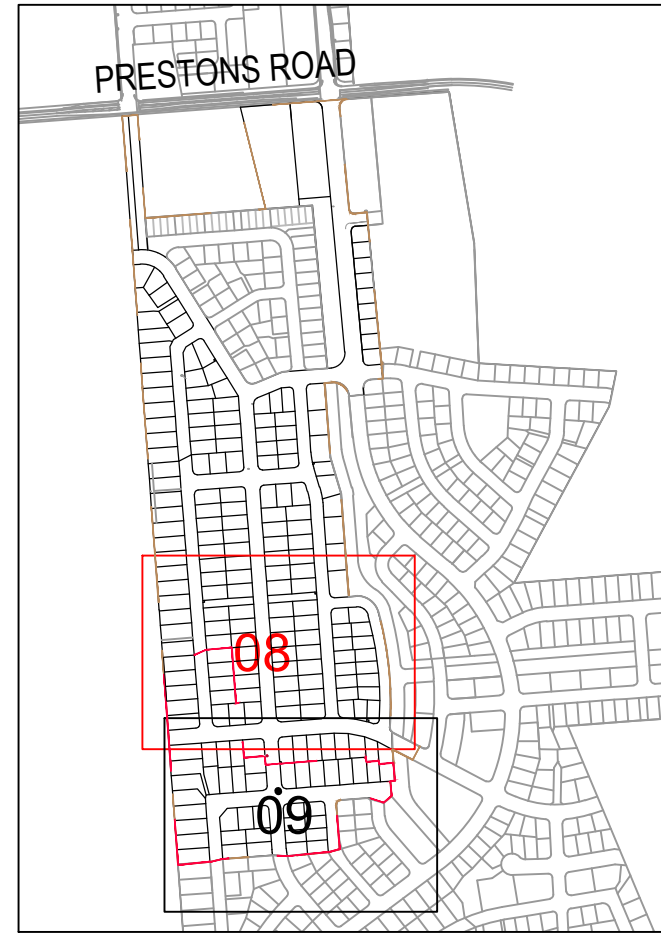

LEGEND:

- STAGE BOUNDARY
- STAGE 0 BOUNDARIES
- VACUUM MAINS PE100 PN12.5 SDR13.6
- 900D
- 1250D
- 2000D
- 2500D
- 2800D
- FLOVAC VACUUM INTERFACE VALVE
- ECCENTRIC REDUCER
- DIVISION VALVE
- MAINTENANCE RISER
- VACUUM SEWER VENT INTAKE PILLAR
- CONCRETE CAPPING
- LIFT

This AS BUILT drawing has been prepared based on information provided by the contractor "KB Contracting".

5 0 10 20m
SCALE 1:500

aurecon
www.aurecongroup.com



CLIENT

REV

DATE

REVISION DETAILS

APPROVED

DRAWN

DESIGNED

PROJECT

AS BUILT

REV	DATE	REVISION DETAILS	APPROVED
4	24/11/16	REISSUE SPREADSHEET UPDATE MH 3A.10	K ASHBY
3	23/11/16	AS BUILT AND SPREADSHEET UPDATE	K ASHBY
2	17/11/16	AS BUILT	K ASHBY
1	04/11/16	AS BUILT	K ASHBY

DRAWN	DESIGNED
J.ANDRELL	J.ANDRELL
CHECKED	
J.TUCKER	
APPROVED	
K ASHBY	DATE 04/11/16
K.ASHBY	

PROJECT
PRESTONS PARK
TITLE
STAGE 1 - SUBSTAGE P STORMWATER AS BUILT LAYOUT PLAN SHEET 2 OF 2

AS BUILT
PROJECT No. 235361
SCALE AS SHOWN
DRAWING No. AB-PS-S1-SP-09
SIZE A1
REV 4

Asset ID	NAME	mE	mN	ASSET DESCRIPTION
1	SS 5.15	395169.74	811968.03	SINGLE SUMP
2	SS 5.09	395246.94	812052.00	SINGLE SUMP
3	SS 5.07	395325.70	812056.18	SINGLE SUMP
4	SS 5.04	395328.40	812042.78	SINGLE SUMP
5	SS 5.08	395255.83	812052.84	SINGLE SUMP
6	SS 5.14	395173.72	812015.16	SINGLE SUMP
7	SS 5.03	395375.84	812051.58	SINGLE SUMP
8	SS 5.2	395262.26	811967.87	SINGLE SUMP
9	SS 5.16	395177.15	811968.62	SINGLE SUMP
10	SS 5.02	395379.69	812058.57	SINGLE SUMP
11	Corner Sump	395333.65	811974.27	SINGLE SUMP
12	SS 5.19	395253.40	811966.83	SINGLE SUMP
13	DS 5.05	395330.66	812012.06	DOUBLE SUMP
14	DS 5.06	395315.92	812047.98	DOUBLE SUMP
15	DS 5.13	395166.16	812016.34	DOUBLE SUMP
16	DS 5.01	395397.67	812056.24	DOUBLE SUMP
17	DS 5.1	395241.16	812042.47	DOUBLE SUMP
18	DS 5.12	395168.88	812043.12	DOUBLE SUMP
19	DS 5.11	395240.53	812049.88	DOUBLE SUMP
20	MH 5B.1	395259.08	811972.59	MH1050
21	MH 5A.8	395174.37	812042.87	MH1200SQ
22	MH 5A.6	395253.60	812049.46	MH1200SQ
23	MH 5A.4	395366.71	812057.10	MH1200SQ
24	MH 5A.10	395171.12	811970.34	MH1200SQ
25	MH 5A.5	395327.95	812054.38	MH1200SQ
26	MH 5A.9	395167.80	812020.13	MH1200SQ
27	MH 5A.7	395245.59	812048.56	MH1200SQ
28	MH 5A.3	395382.31	812055.59	MH1200SQ
29	MH 5A.2	395399.45	812060.62	MH1200SQ
30	MH 5A.1	395424.34	812067.16	OUTLET
31	MH 3A.10	395154.42	812196.34	MH1200SQ