




SHEET LAYOUT:

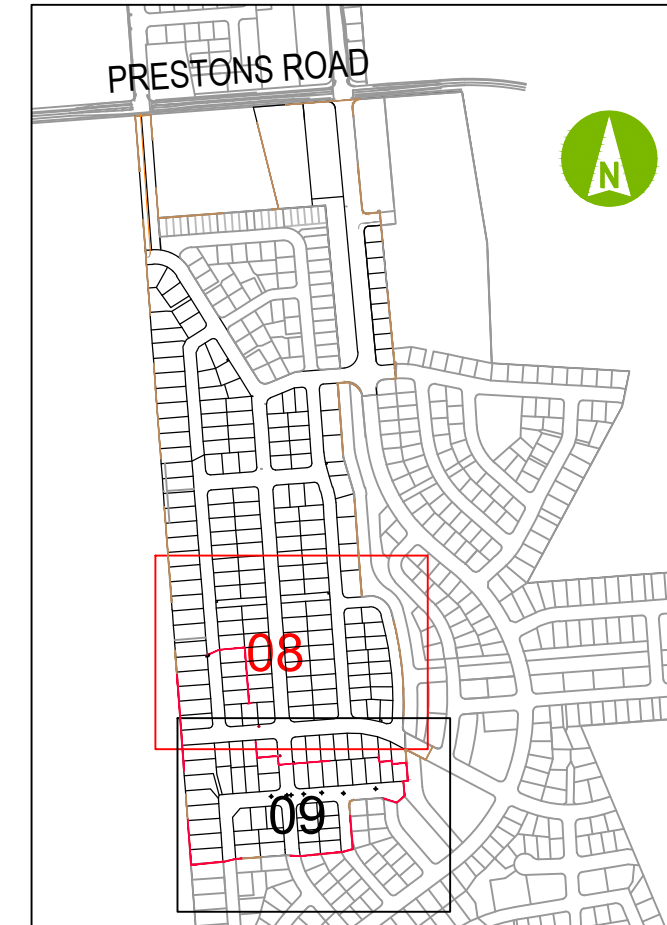

LEGEND:

STAGE BOUNDARY	
STAGE 0 BOUNDARIES	
VACUUM MAINS PE100 PN12.5 SDR13.6	
900D	
1250D	
2000D	
2500D	
2800D	
FLOWAC VACUUM INTERFACE VALVE	
ECCENTRIC REDUCER	
DIVISION VALVE	
MAINTENANCE RISER	
VACUUM SEWER VENT INTAKE PILLAR	
CONCRETE CAPPING	
LIFT	

This AS BUILT drawing has been prepared based on information provided by the contractor "KB Contracting".

5 0 10 20m
SCALE 1:500

aurecon
www.aurecongroup.com



CLIENT

REV	DATE	REVISION DETAILS
2	04/11/16	AS BUILT
1	10/10/16	AS BUILT

APPROVED

DRAWN L KEATS	DESIGNED L KEATS
CHECKED J.WHITE	APPROVED
K.ASHBY	K.ASHBY
K.ASHBY	K.ASHBY

PROJECT		AS BUILT	
PRESTONS PARK		PROJECT No. 235361	
TITLE		SCALE 1:500	SIZE A1
STAGE 1 - SUBSTAGE P VACUUM SEWER AS BUILT LAYOUT PLAN SHEET 1 OF 2		DRAWING No. AB-PS-S1-VS-08	REV 2