





SHEET LAYOUT:

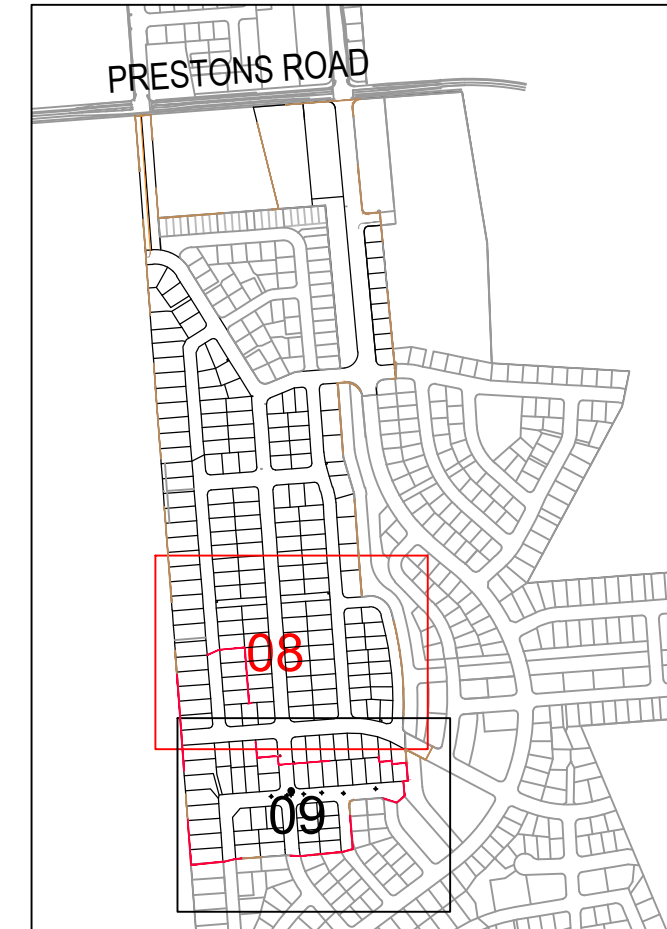

LEGEND:

- STAGE BOUNDARY
- STAGE 0 BOUNDARIES
- VACUUM MAINS PE100 PN12.5 SDR13.6
 - 900D
 - 1250D
 - 2000D
 - 2500D
 - 2800D
- FLOWAC VACUUM INTERFACE VALVE
- ECCENTRIC REDUCER
- DIVISION VALVE
- MAINTENANCE RISER
- VACUUM SEWER VENT INTAKE PILLAR
- CONCRETE CAPPING
- LIFT

This AS BUILT drawing has been prepared based on information provided by the contractor "KB Contracting".

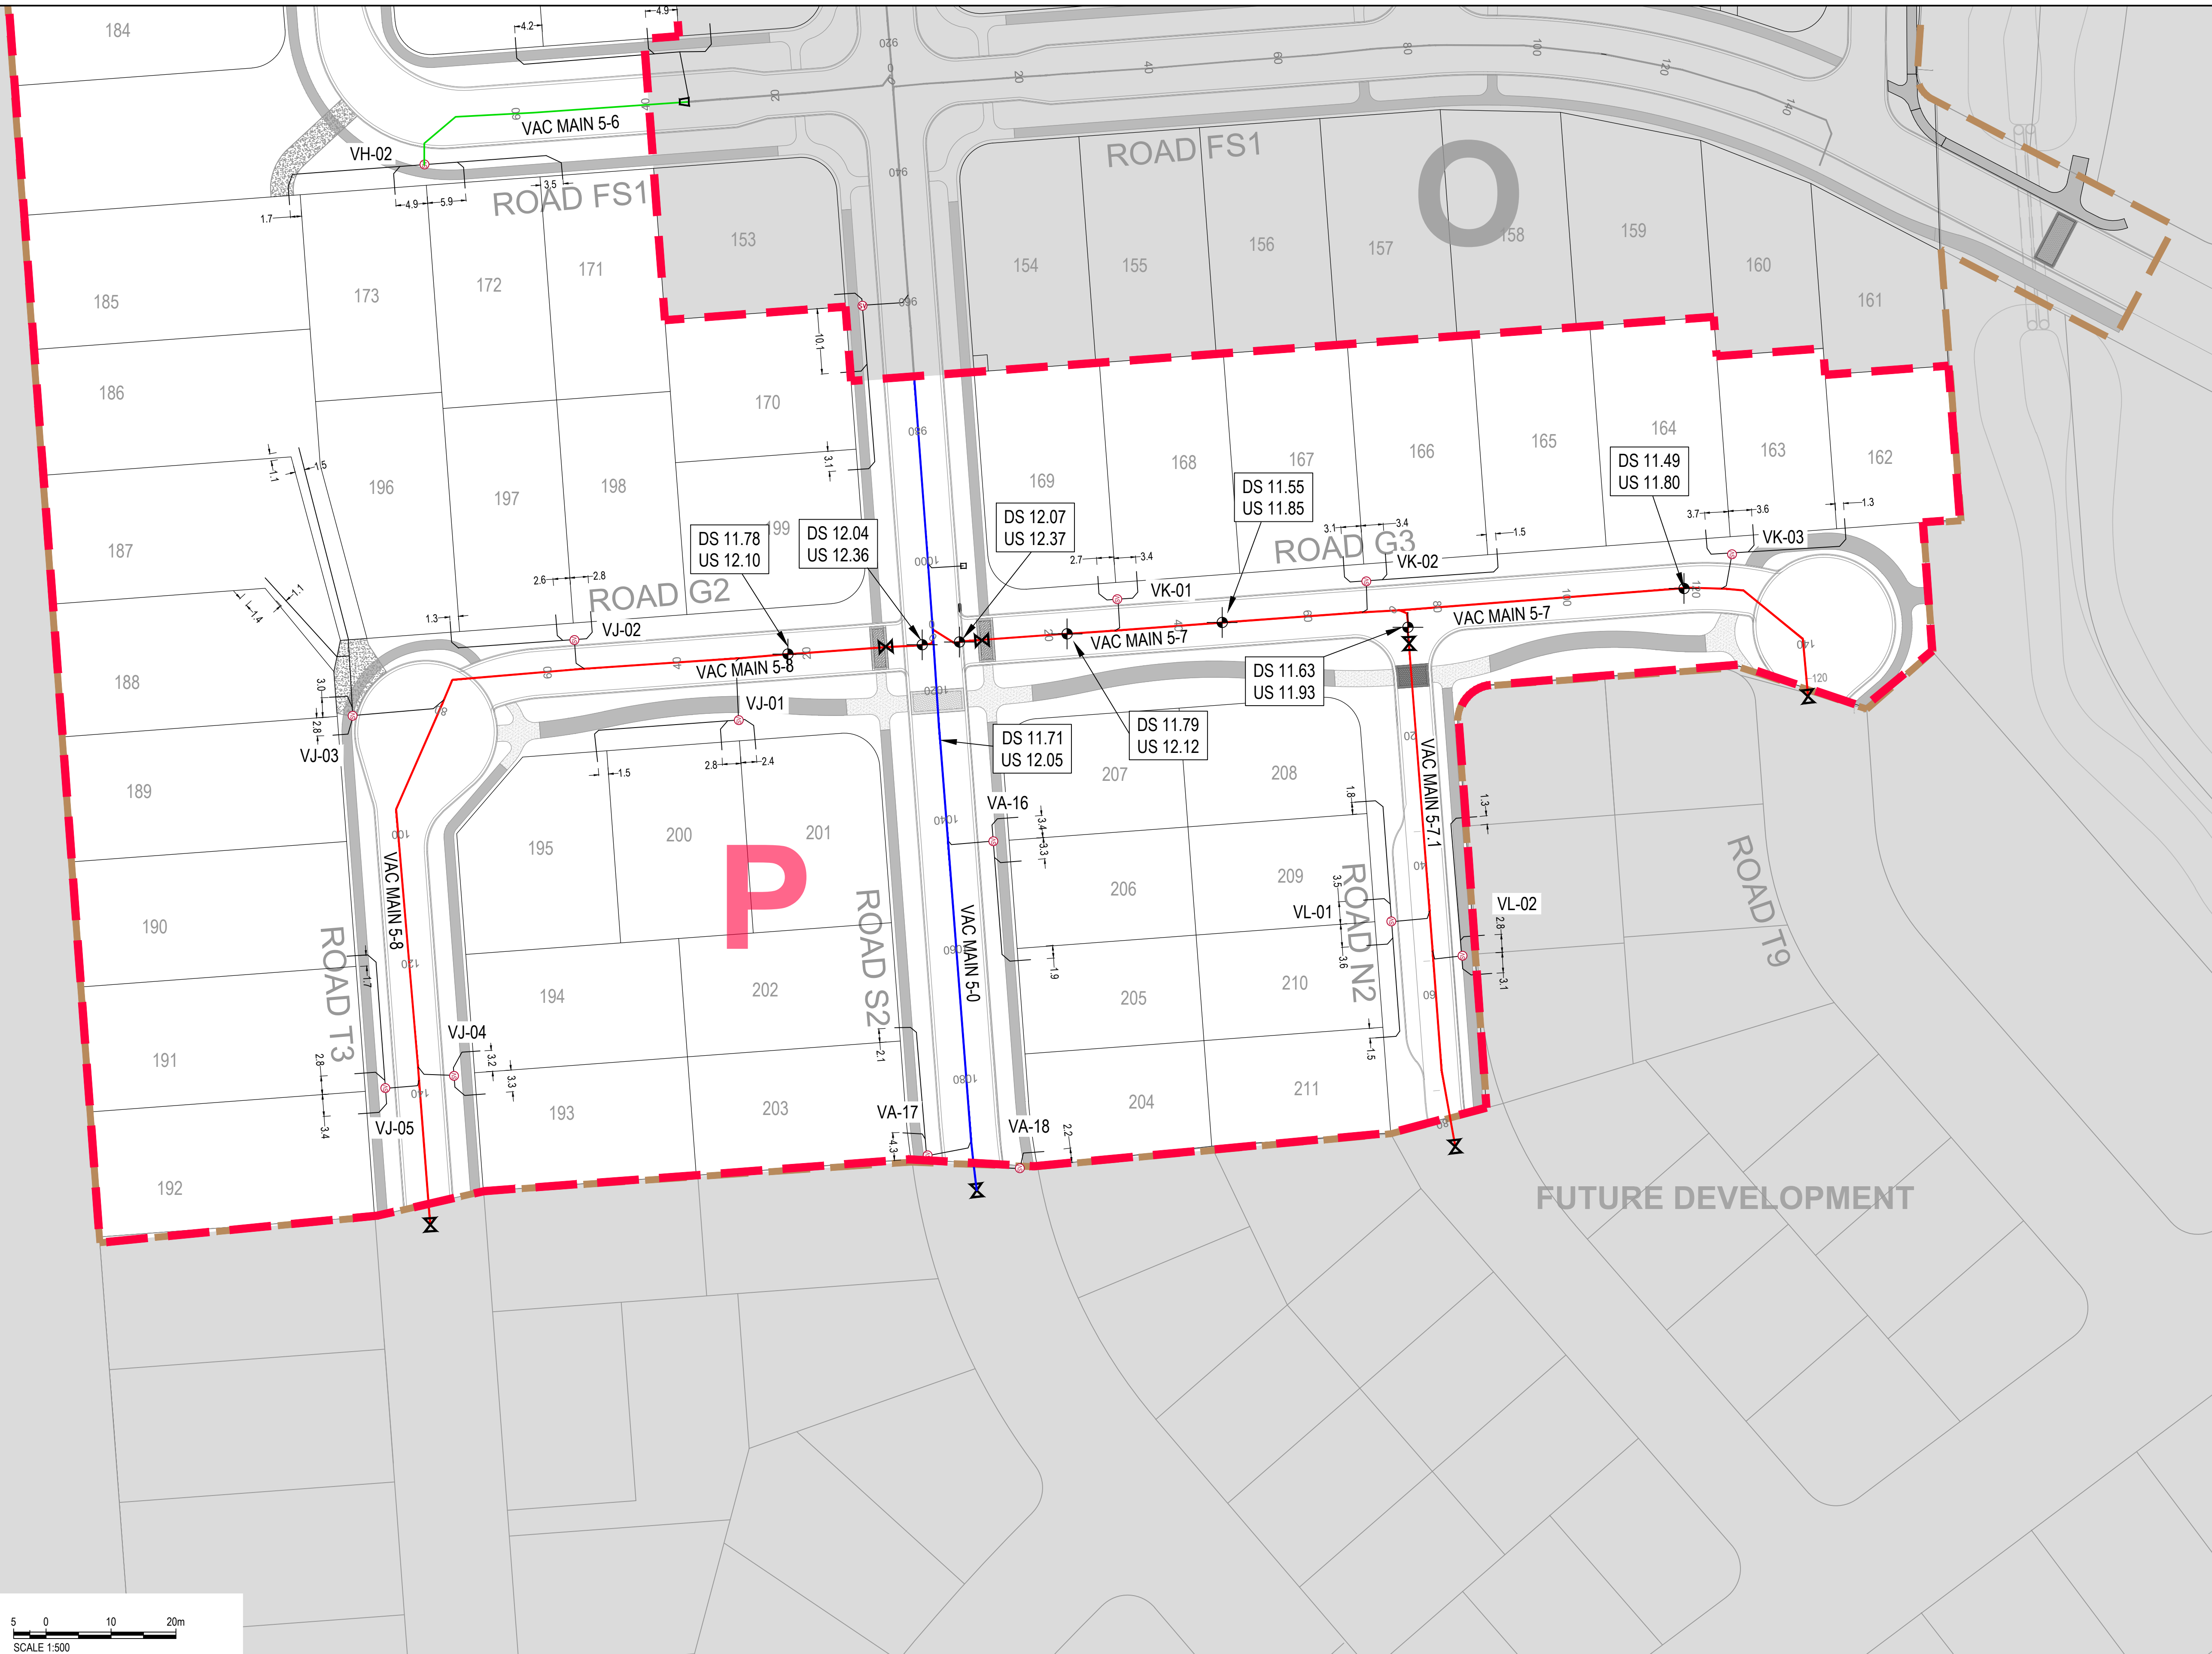

FUTURE DEVELOPMENT



REV	DATE	REVISION DETAILS	APPROVED
2	04/11/16	AS BUILT	KASHBY
1	10/10/16	AS BUILT	KASHBY

DRAWN	DESIGNED
L KEATS	L KEATS
CHECKED J.WHITE	
APPROVED	
K.ASHBY	DATE 04/11/16
K.ASHBY	

PROJECT
PRESTONS PARK
TITLE
STAGE 1 - SUBSTAGE P VACUUM SEWER AS BUILT LAYOUT PLAN SHEET 2 OF 2

AS BUILT	
PROJECT No.	235361
SCALE	1:500
DRAWING No.	AB-PS-S1-VS-09
SIZE	A1
REV	2