

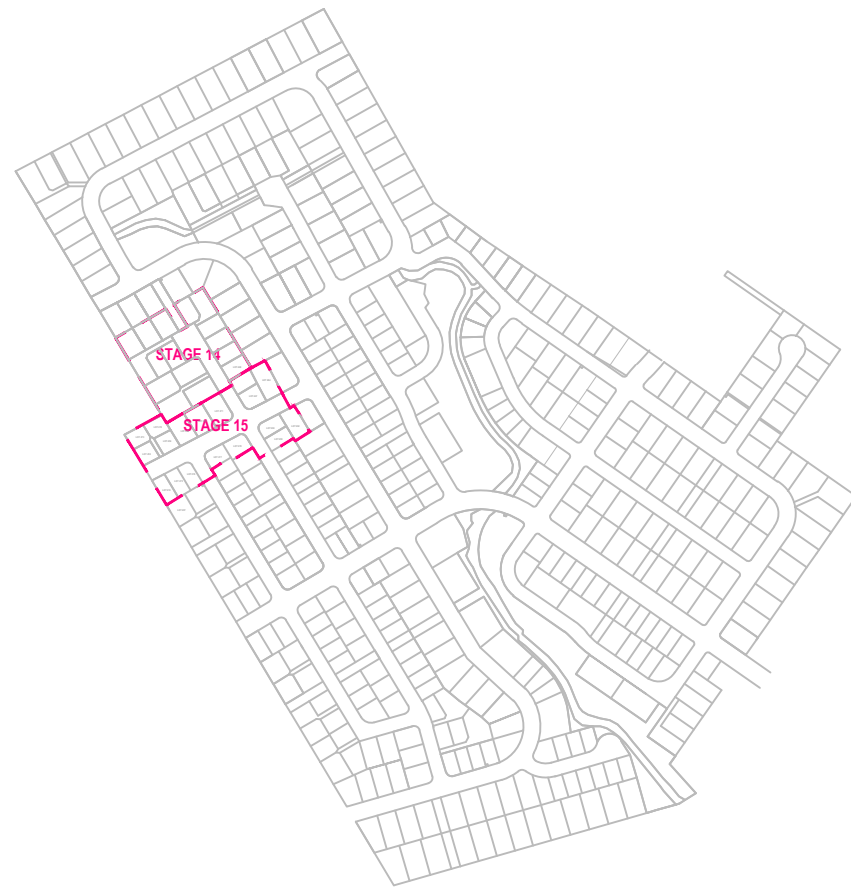


NOTES:
 AS BUILT INFORMATION HAS BEEN SUPPLIED BY KBs
 CONTRACTING & QUARRIES LTD - AUGUST 2014.
 HEIGHTS ARE IN TERMS OF MEAN SEA LEVEL
 ALL LATERALS ARE 20mmØ ID POLY

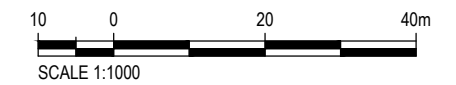

LOCATION PLAN

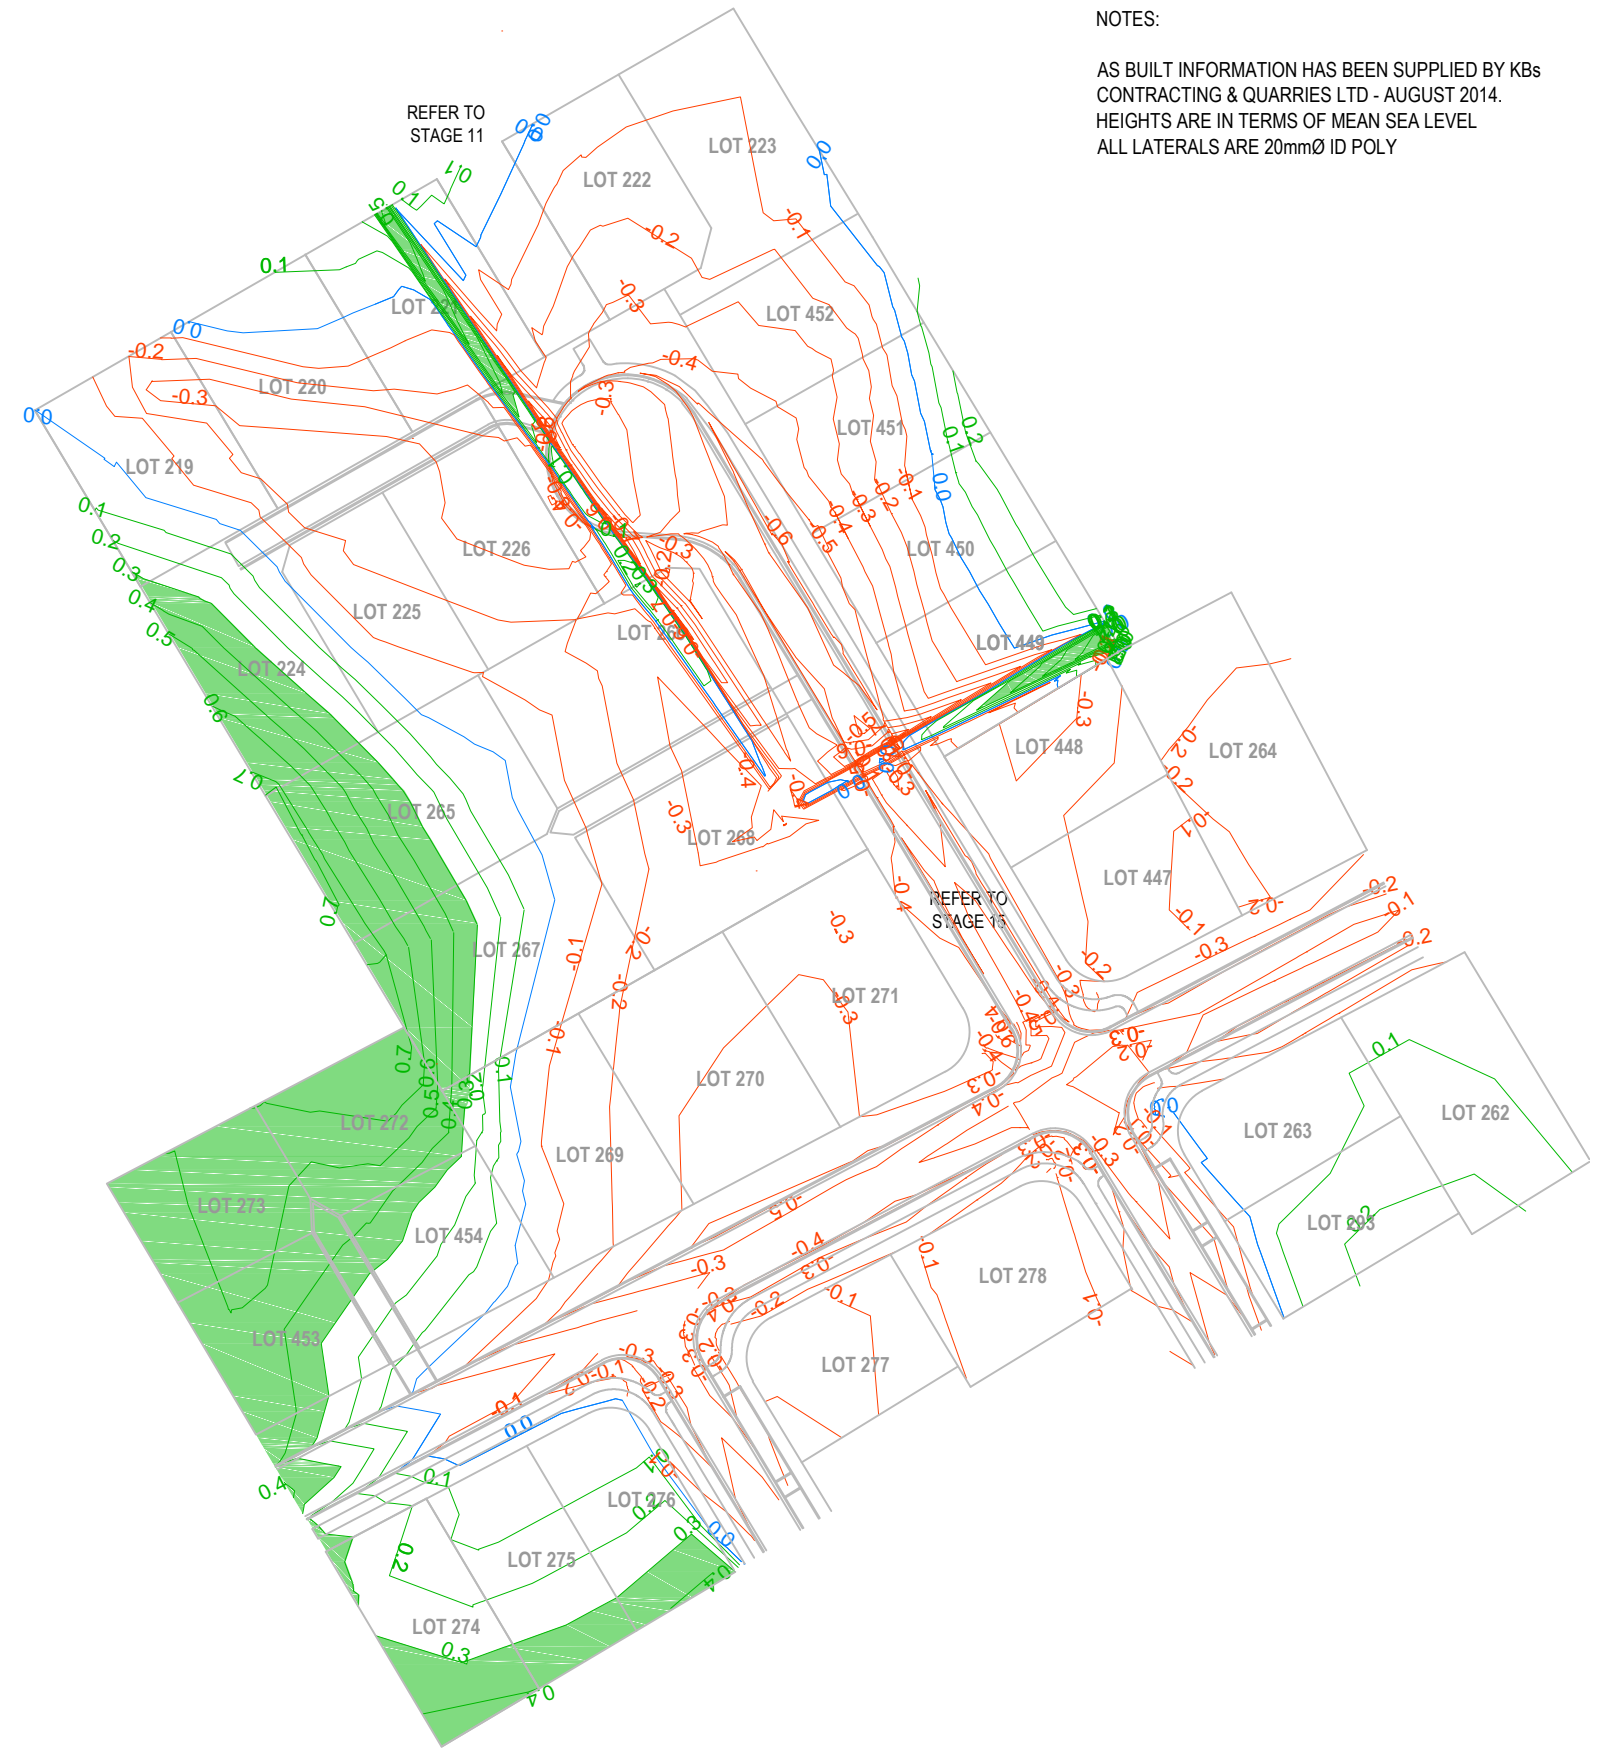

0000000



REV	DATE	REVISION DETAILS	APPROVED
A	17.04.15	AS BUILTS ISSUED	B.TOMS

CLIENT	DATE	REVISION DETAILS	APPROVED

DRAWN	DESIGNED
A.COLUMBUS	M.CROWE
CHECKED	
D.WATSON	
APPROVED	
B.TOMS	DATE 17.04.15
B.TOMS	

PROJECT
STONEBROOK ROLLESTON
TITLE
STAGE 14 & 15 CUT FILL AS BUILT

AS BUILT	PROJECT No.	224926
SCALE	AS SHOWN	A3
DRAWING No.	DW-LD-S14-AB-CF-01	REV
		A