



NOTE:
SUBJECT TO COUNCIL ACCEPTANCE

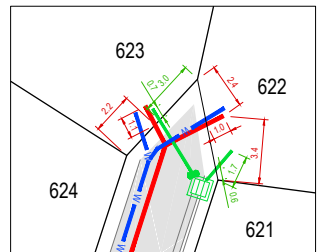

DETAIL 1
1:200

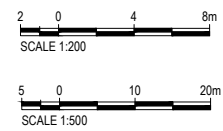

LEGEND	
	SUB-STAGE X BOUNDARY
	STORMWATER TO STREET
	DOUBLE SUMP
	SINGLE SUMP
	CORNER SUMP
	SEWER LATERAL TO MAINS
	WATER SUBMAIN



REV	DATE	REVISION DETAILS	APPROVED
A	16/11/17	ISSUE FOR INFORMATION	K ASHBY

DRAWN	R DAWSON	DESIGNED	C DOHERTY
CHECKED	M CROWE	APPROVED	
	K ASHBY	DATE	16/11/2017
	K ASHBY		

CLIENT	PROJECT
PRESTONS PARK	AS-BUILT SEWER & STORMWATER STAGE 2 - SUB STAGE X

PRELIMINARY NOT FOR CONSTRUCTION	
PROJECT No. 235361	
SCALE 1:500	SIZE A1
DRAWING No. AB-PS-S2-SP-02	REV A