

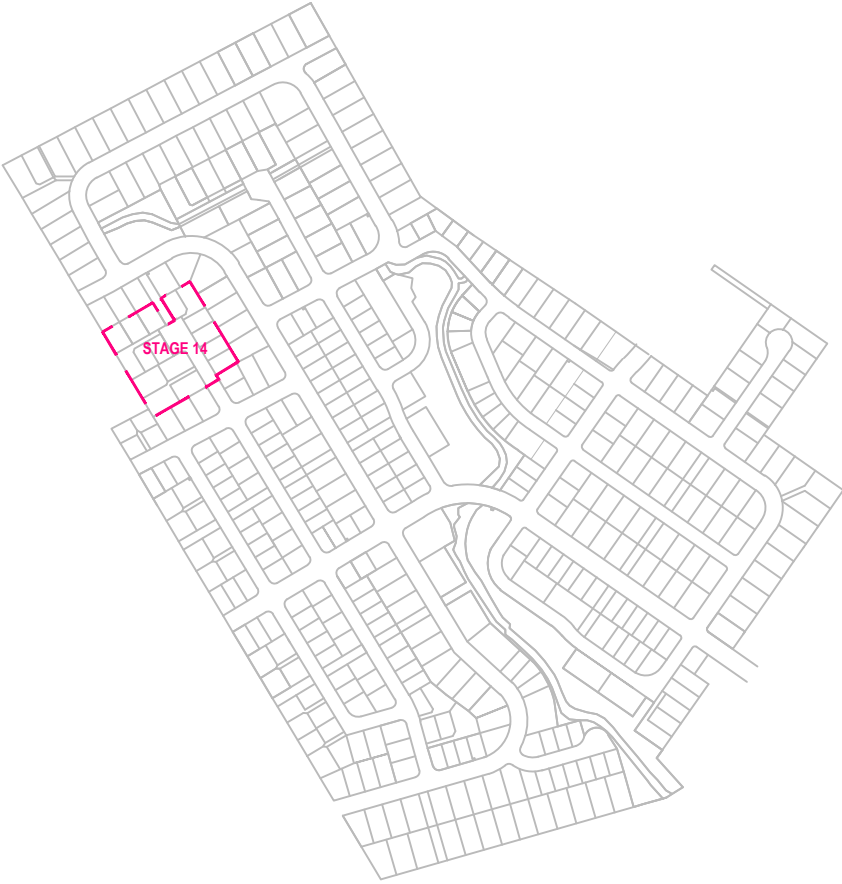


NOTES:

AS BUILT INFORMATION HAS BEEN SUPPLIED BY KBs  
CONTRACTING & QUARRIES LTD - AUGUST 2014.  
HEIGHTS ARE IN TERMS OF MEAN SEA LEVEL  
ALL LATERALS ARE 20mmØ ID POLY

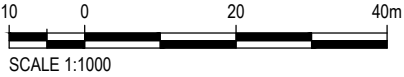

LOCATION PLAN

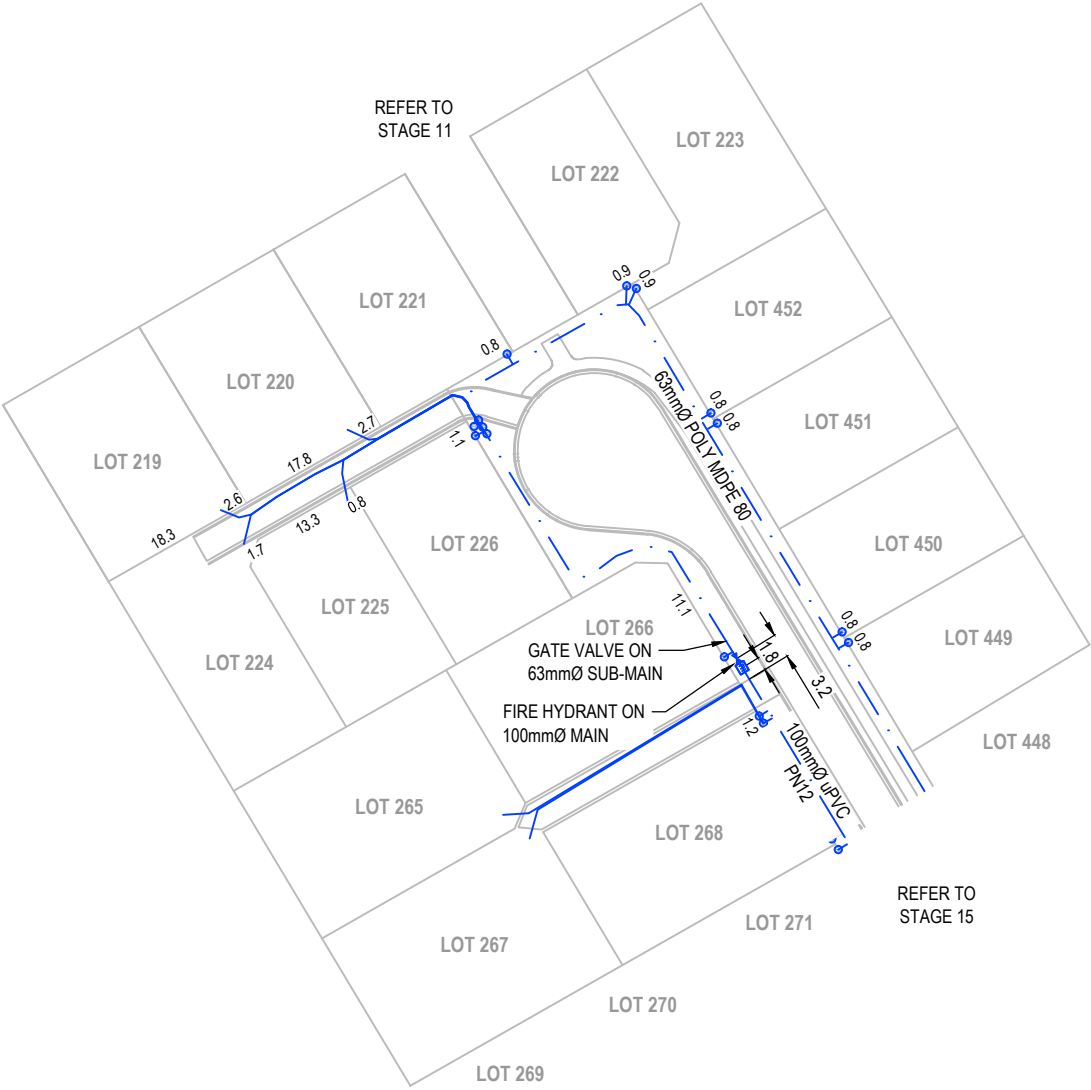

REV	DATE	REVISION DETAILS	APPROVED
A	17.04.15	AS BUILTS ISSUED	B.TOMS

DRAWN	DESIGNED
A.COLUMBUS	M.CROWE
CHECKED	
D.WATSON	
APPROVED	
B.TOMS	
DATE 17.04.15	

PROJECT	
STONEBROOK ROLLESTON	
TITLE	
STAGE 14 WATER AS BUILT	

AS BUILT	
PROJECT No. 224926	
SCALE AS SHOWN	SIZE A3
DRAWING No. DW-LD-S14-AB-W-01	REV A