




NOTES:

AS BUILT INFORMATION HAS BEEN SUPPLIED BY KBs  
CONTRACTING & QUARRIES LTD - DECEMBER 2014.  
HEIGHTS ARE IN TERMS OF MEAN SEA LEVEL

RS = ROAD SUMP IN SDC LOW PROFILE KERB AND CHANNEL

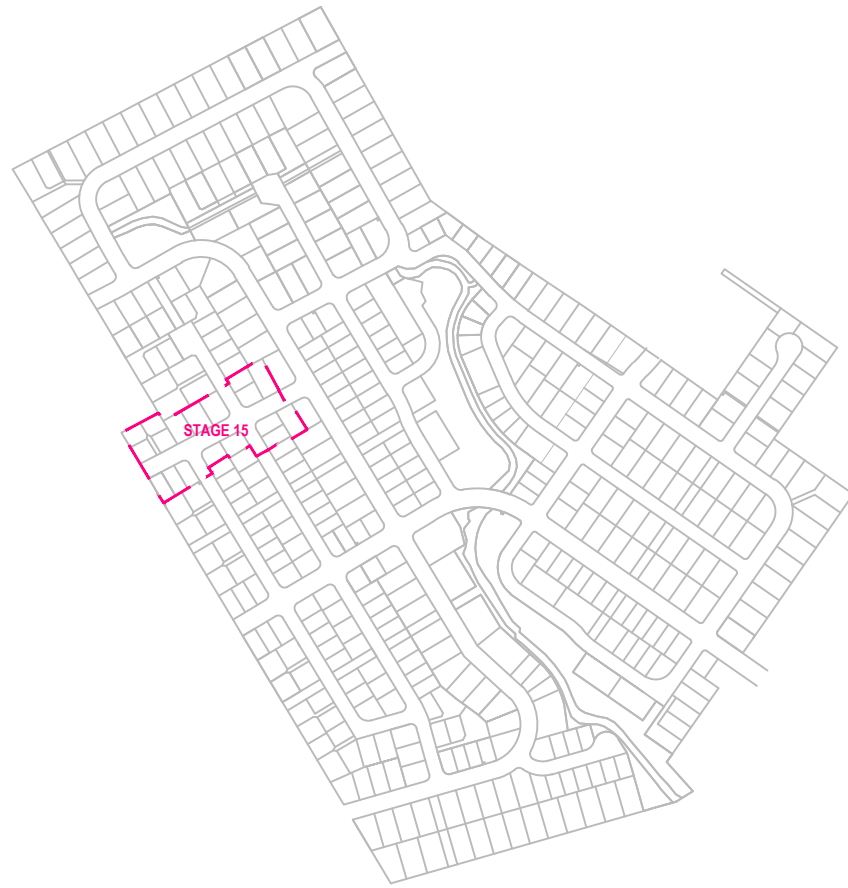

LOCATION PLAN

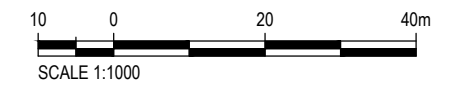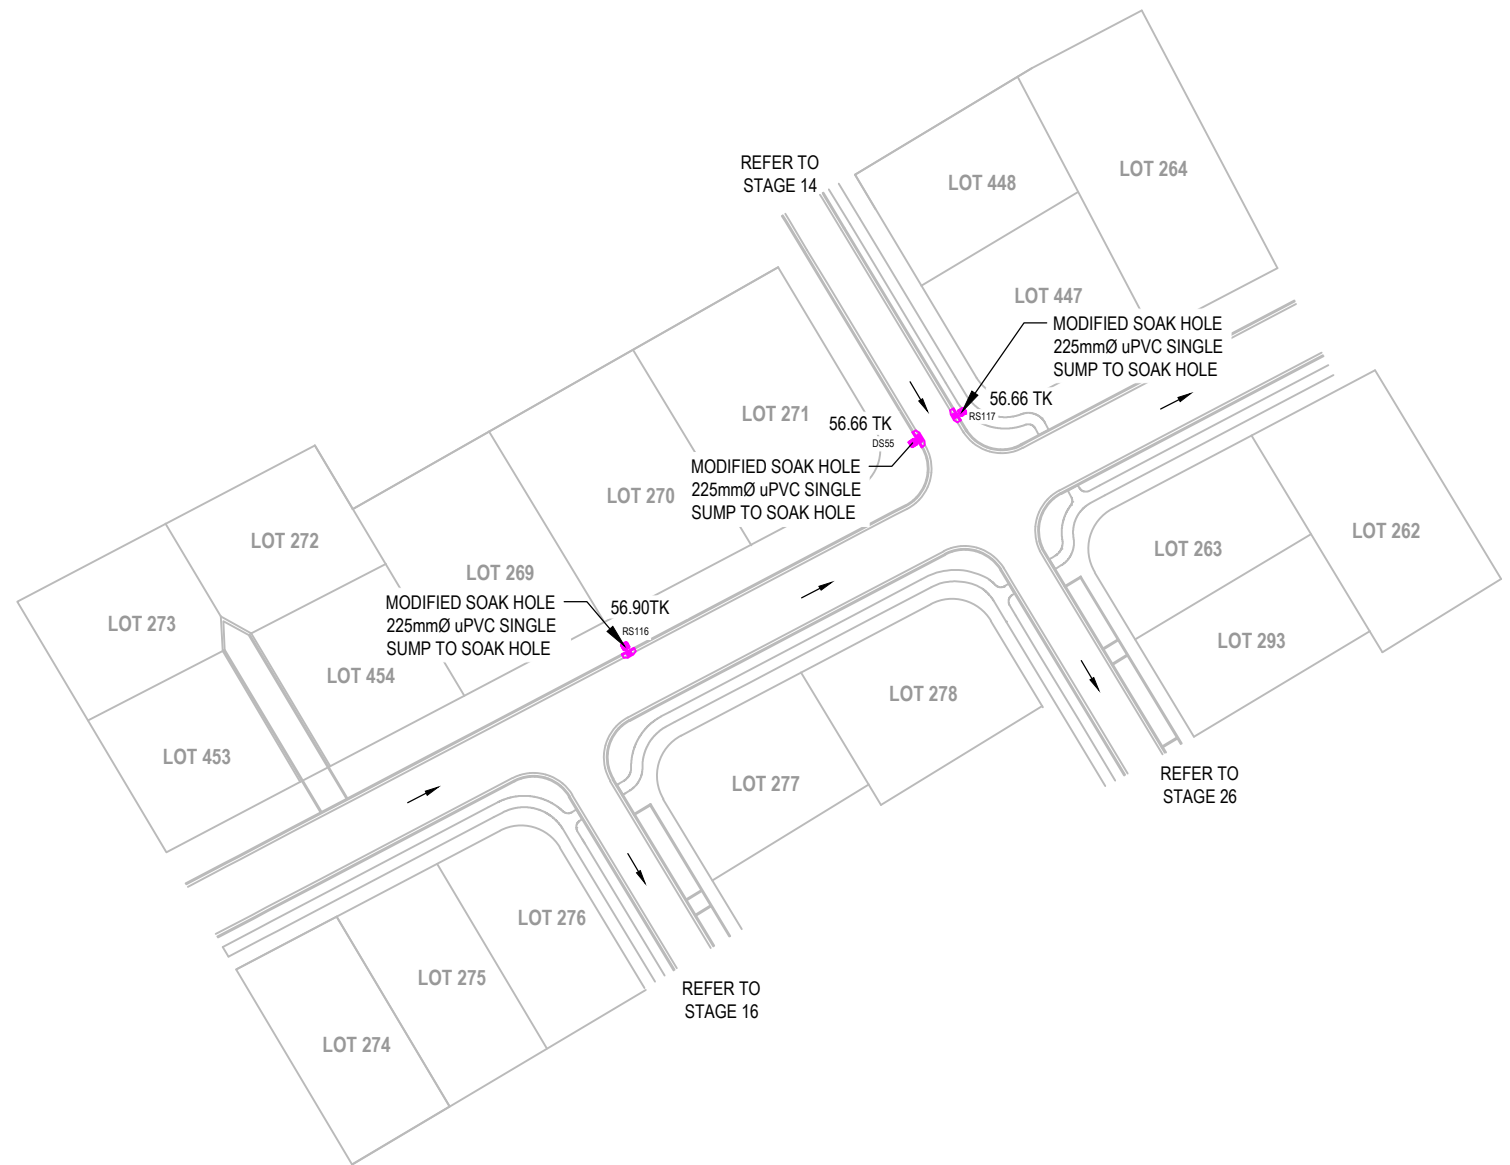

000000



CLIENT

REV	DATE	REVISION DETAILS	APPROVED
A	17.04.15	AS BUILTS ISSUED	B.TOMS

DRAWN	DESIGNED
A.COLUMBUS	M.CROWE
CHECKED	
D.WATSON	
APPROVED	
B.TOMS	DATE 17.04.15
B.TOMS	

PROJECT
STONEBROOK ROLLESTON
TITLE
STAGE 15 STORMWATER AS BUILT

AS BUILT	
PROJECT No.	224926
SCALE	A3
AS SHOWN	
DRAWING No.	DW-LD-S15-AB-SW-01
REV	A