

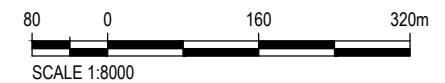


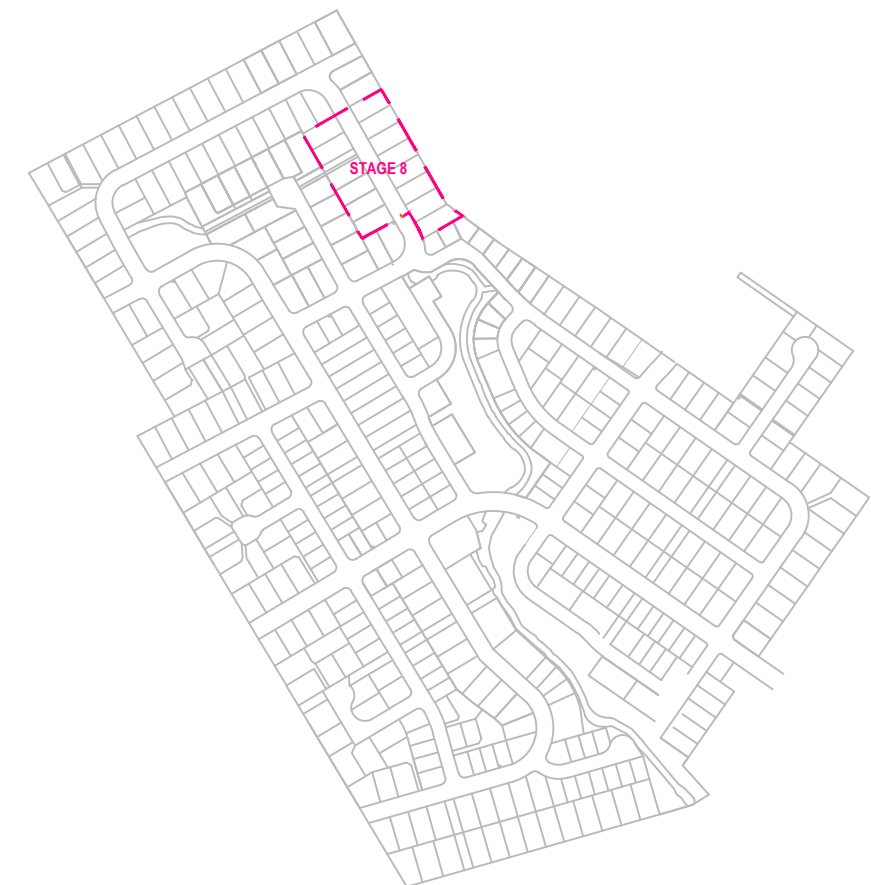

NOTES:

AS BUILT INFORMATION HAS BEEN SUPPLIED BY KBs CONTRACTING & QUARRIES LTD - AUGUST 2014.
 HEIGHTS ARE IN TERMS OF MEAN SEA LEVEL
 ALL LATERALS ARE 100mmØ uPVC SN16

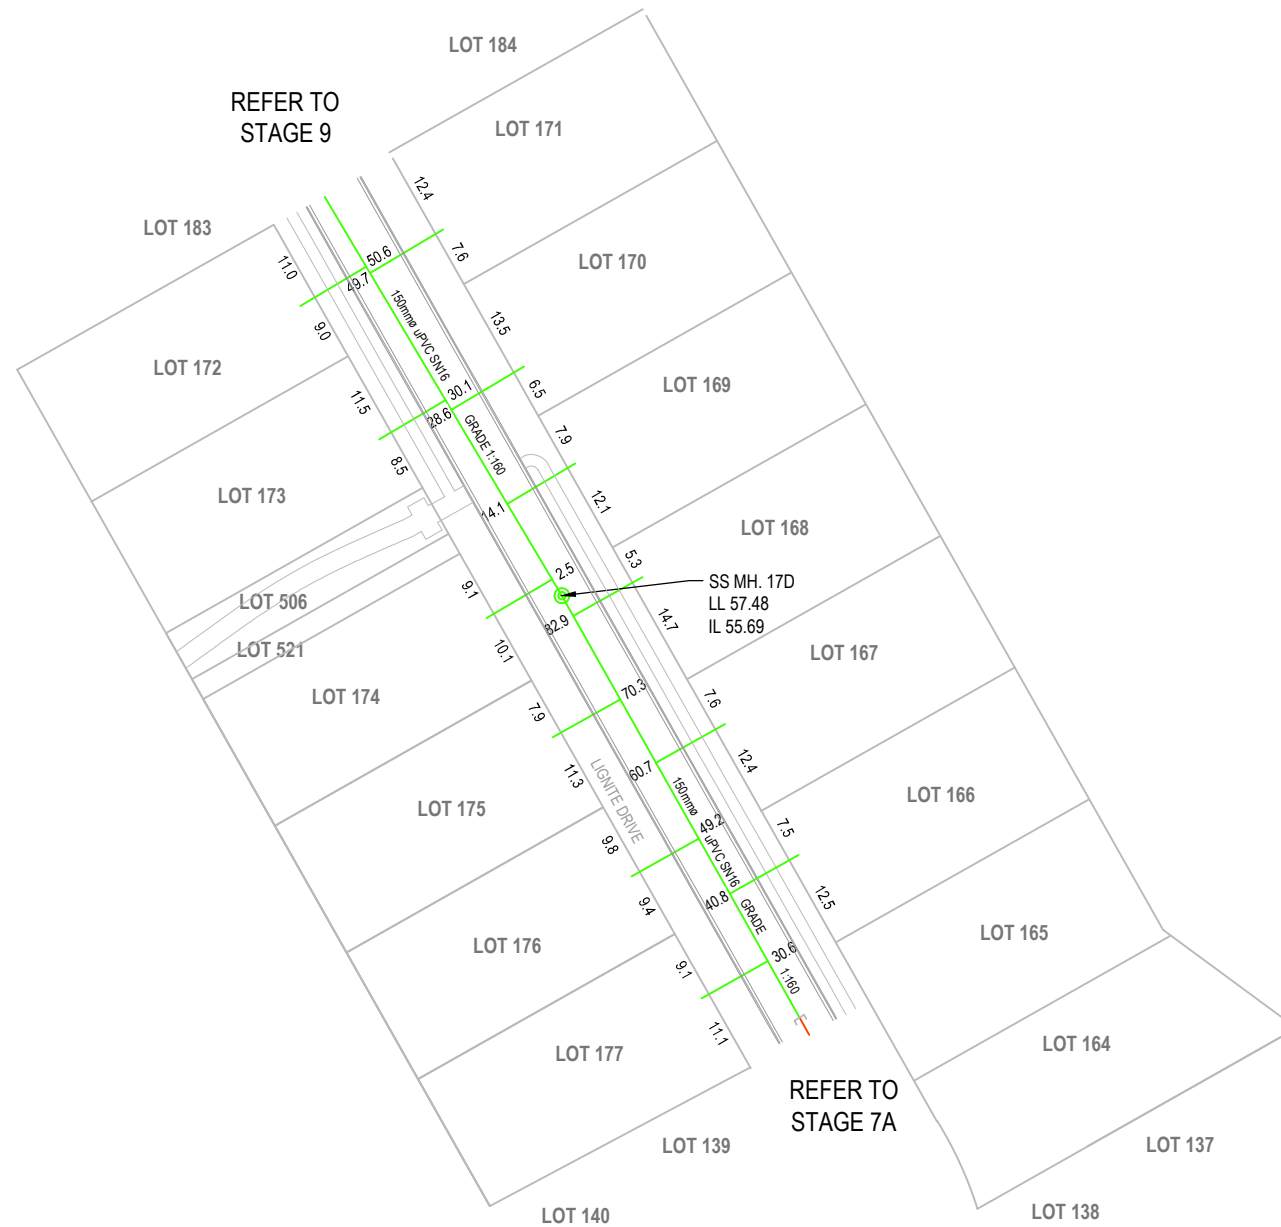

000000



CLIENT		REV	DATE	REVISION DETAILS	APPROVED	DRAWN	DESIGNED	PROJECT		AS BUILT	
						A.COLUMBUS	M.CROWE	STONEBROOK ROLLESTON		PROJECT No. 224926	
						CHECKED D.WATSON		TITLE		SCALE	SIZE
						APPROVED	DATE	STAGE 8 SEWER AS BUILTS		AS SHOWN	A3
										DRAWING No.	REV
		A		AS BUILTS ISSUED	B.TOMS	B.TOMS				DW-LD-S8-AB-SS-01	A