



NOTES:

AS BUILT INFORMATION HAS BEEN SUPPLIED BY KBs CONTRACTING & QUARRIES LTD - AUGUST 2014.
HEIGHTS ARE IN TERMS OF MEAN SEA LEVEL

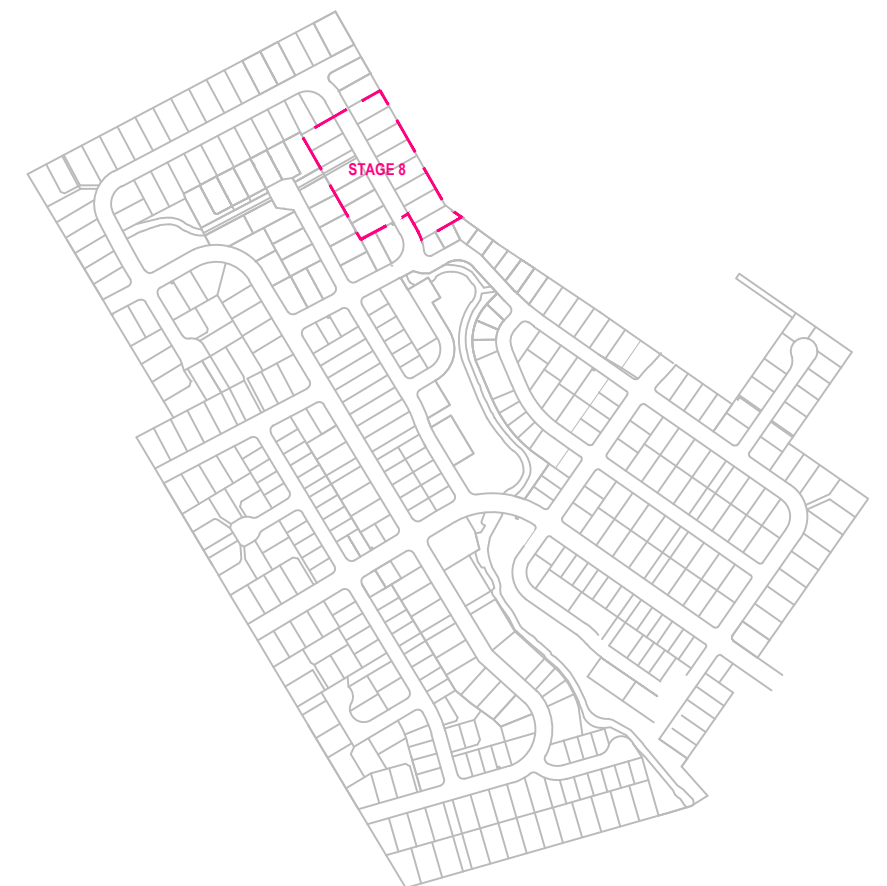

RS = ROAD SUMP IN SDC LOW PROFILE KERB AND CHANNEL

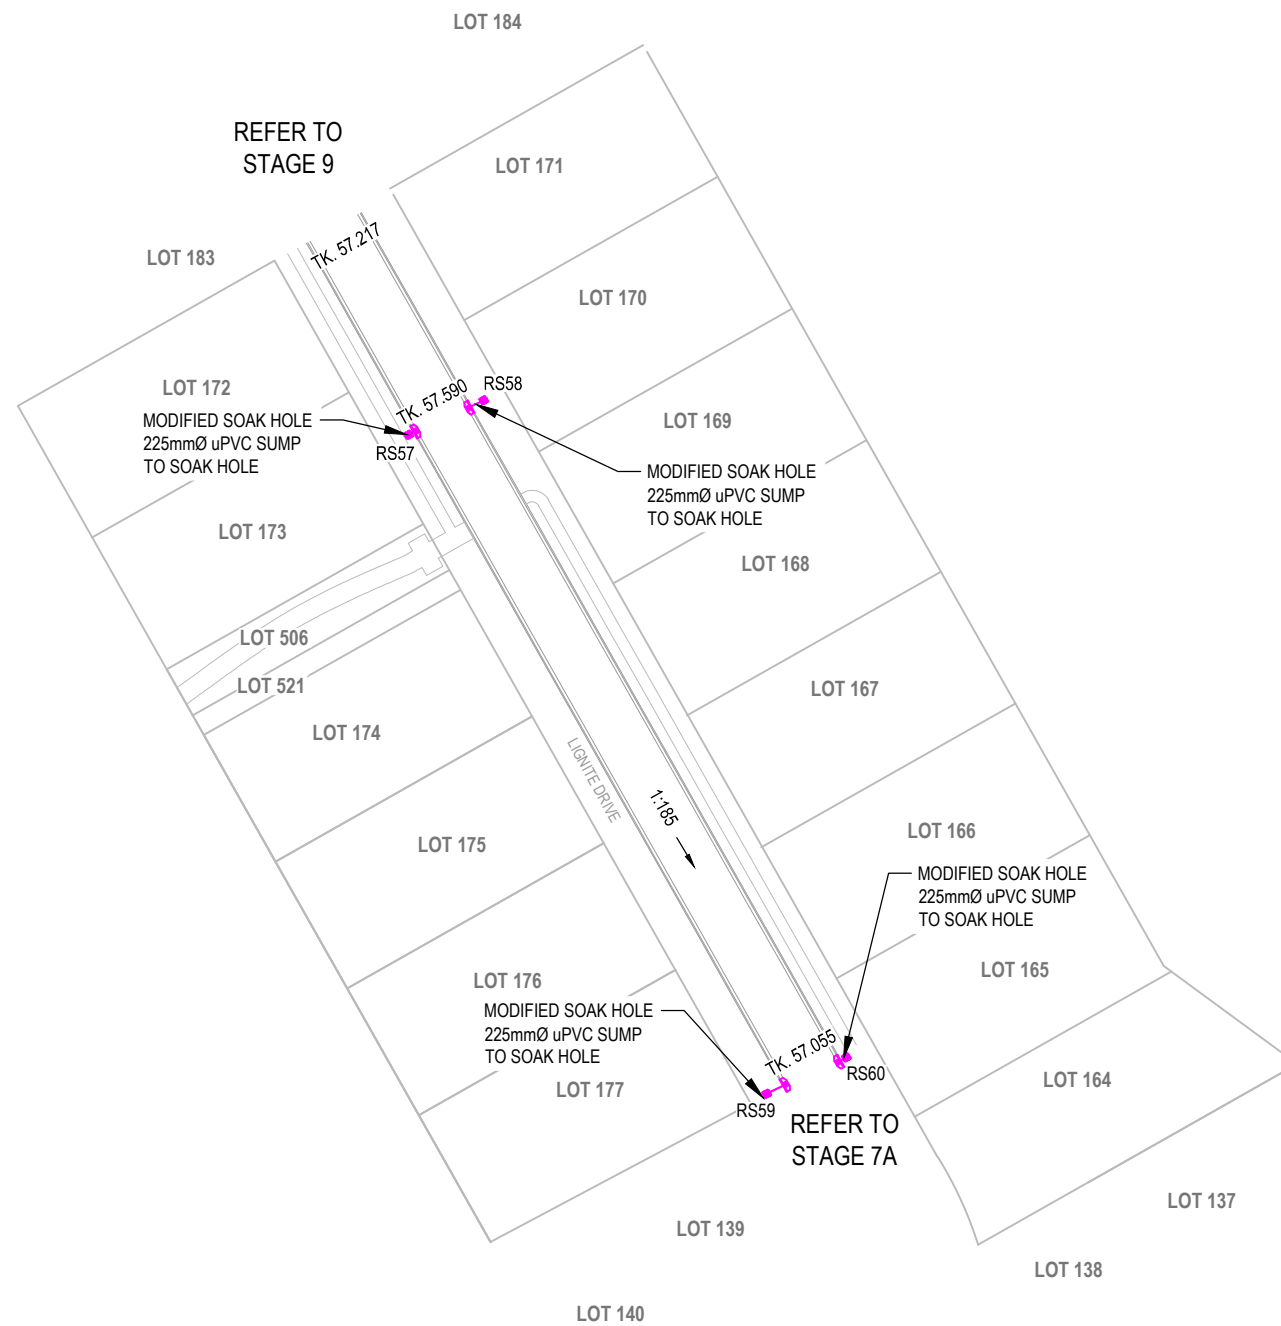

LOCATION PLAN



REV	DATE	REVISION DETAILS	APPROVED
A		AS BUILTS ISSUED	B.TOMS

CLIENT	DATE	REVISION DETAILS	APPROVED

DRAWN	DESIGNED
A.COLUMBUS	M.CROWE
CHECKED	
D.WATSON	
APPROVED	
B.TOMS	

PROJECT
STONEBROOK ROLLESTON
TITLE
STAGE 8 STORMWATER AS BUILT

AS BUILT
PROJECT No. 224926
SCALE AS SHOWN
DRAWING No. DW-LD-S8-AB-SW-01
SIZE A3
REV A