


NOTES:

AS BUILT INFORMATION HAS BEEN SUPPLIED BY KBs CONTRACTING & QUARRIES LTD - AUGUST 2014.  
HEIGHTS ARE IN TERMS OF MEAN SEA LEVEL



RS = ROAD SUMP IN SDC LOW PROFILE KERB AND CHANNEL

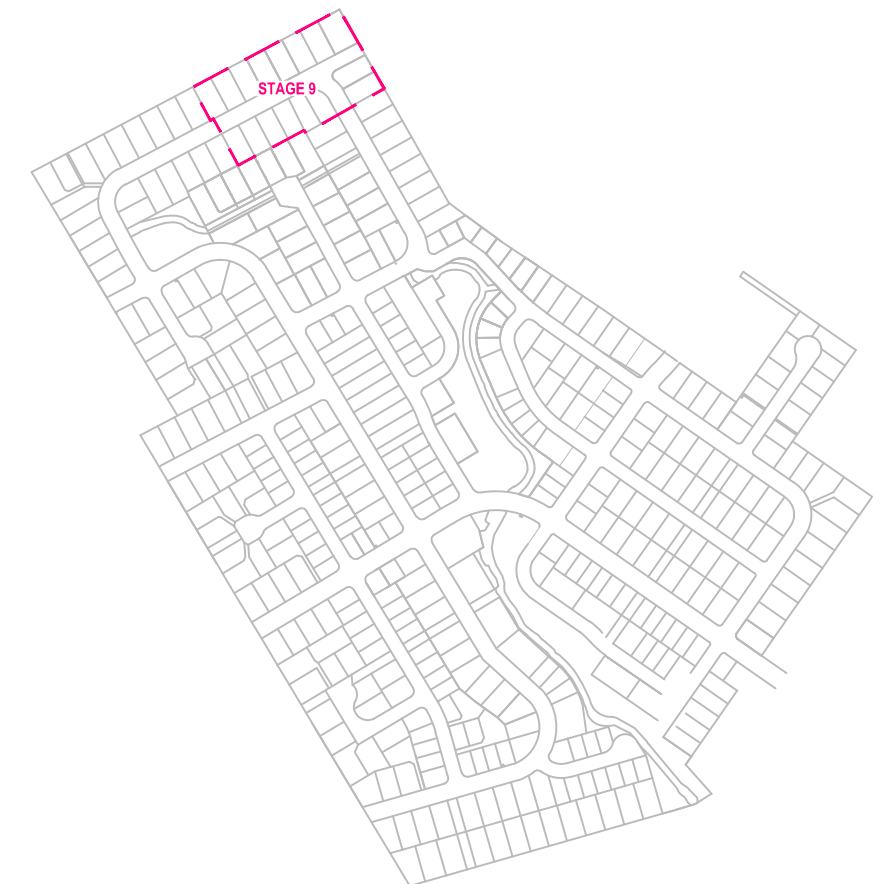

LOCATION PLAN



REV	DATE	REVISION DETAILS	APPROVED
A	15.09.14	AS BUILTS ISSUED	B.TOMS

DRAWN	DESIGNED
A.COLUMBUS	M.CROWE
CHECKED	
D.WATSON	
APPROVED	
B.TOMS	
	DATE

PROJECT
STONEBROOK ROLLESTON
TITLE
STAGE 9 STORMWATER AS BUILT

AS BUILT
PROJECT No. 224926
SCALE AS SHOWN
DRAWING No. DW-LD-S9-AB-SW-01
SIZE A3
REV A

000000