



NOTES:

AS BUILT INFORMATION HAS BEEN SUPPLIED BY KBs  
 CONTRACTING & QUARRIES LTD - AUGUST 2014.  
 HEIGHTS ARE IN TERMS OF MEAN SEA LEVEL  
 ALL LATERALS ARE 20mmØ ID POLY

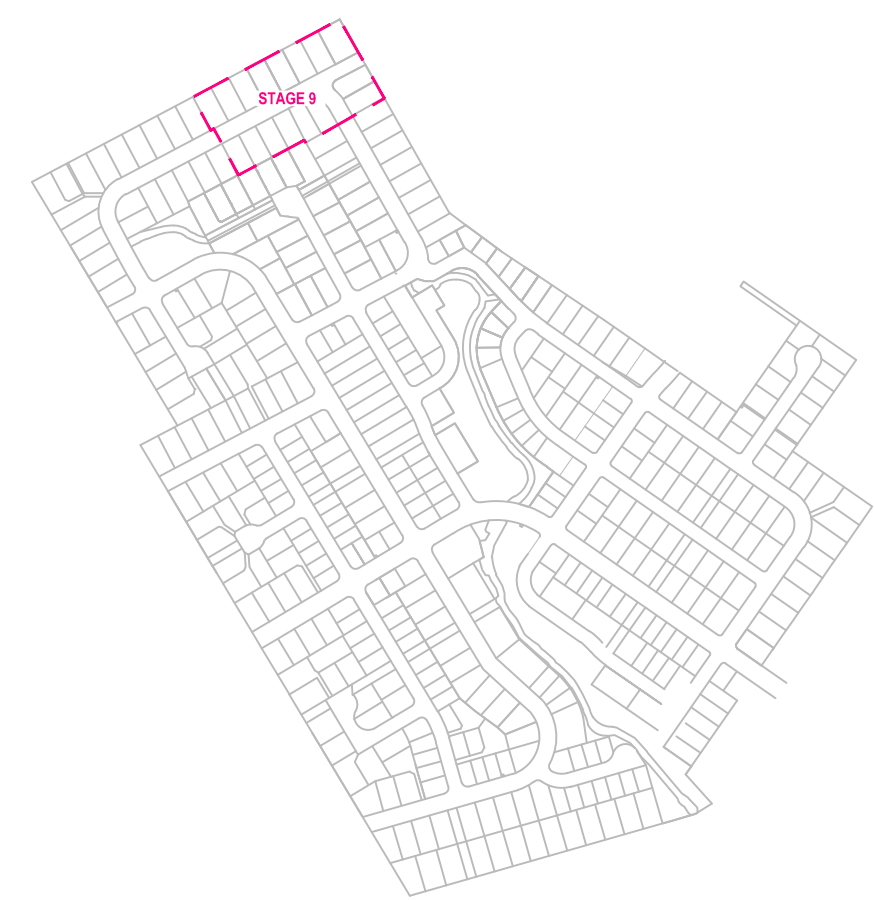

LOCATION PLAN

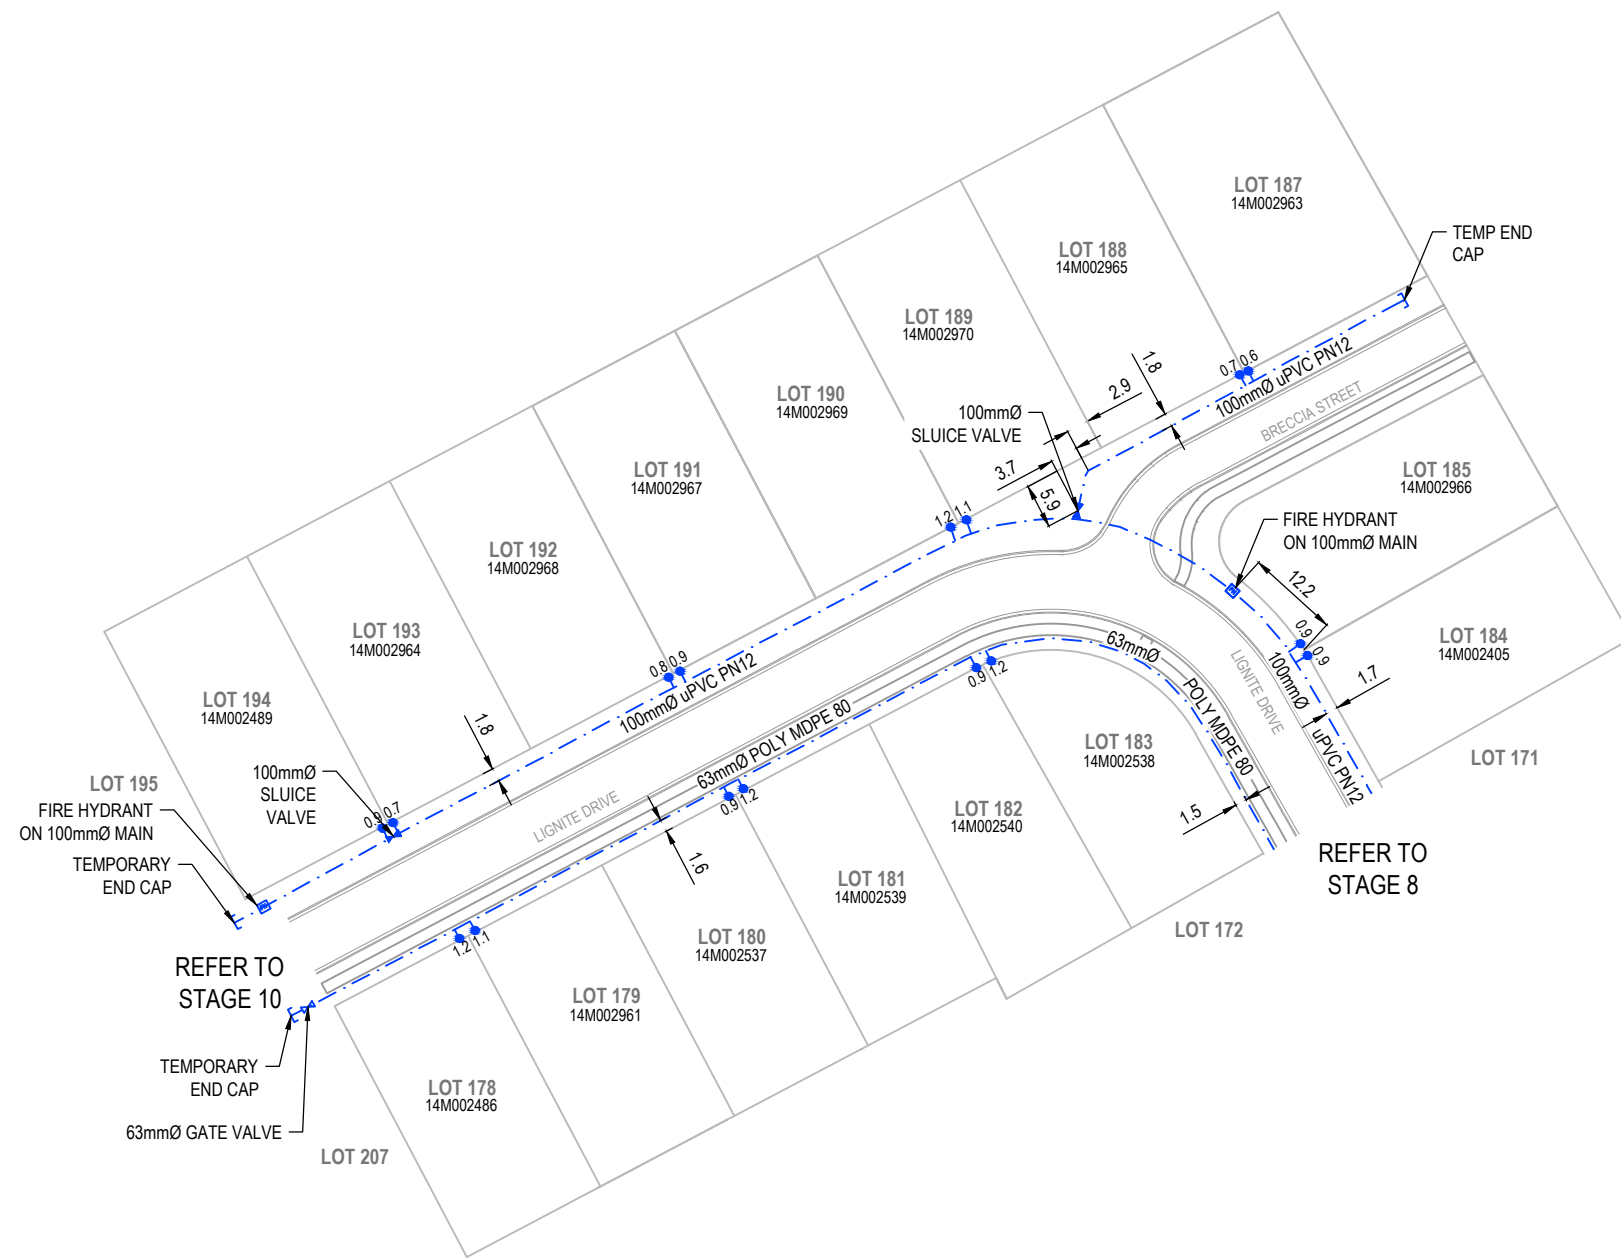

000000



CLIENT		REV	DATE	REVISION DETAILS	APPROVED	DRAWN	DESIGNED	PROJECT		AS BUILT	
						A.COLUMBUS	M.CROWE	STONEBROOK ROLLESTON		PROJECT No. 224926	
						CHECKED D.WATSON		TITLE		SCALE	SIZE
						APPROVED	DATE	STAGE 9 WATER AS BUILT		AS SHOWN	A3
										DRAWING No.	REV
		A	15.09.14	AS BUILTS ISSUED	B.TOMS	B.TOMS				DW-LD-S9-AB-W-01	A