

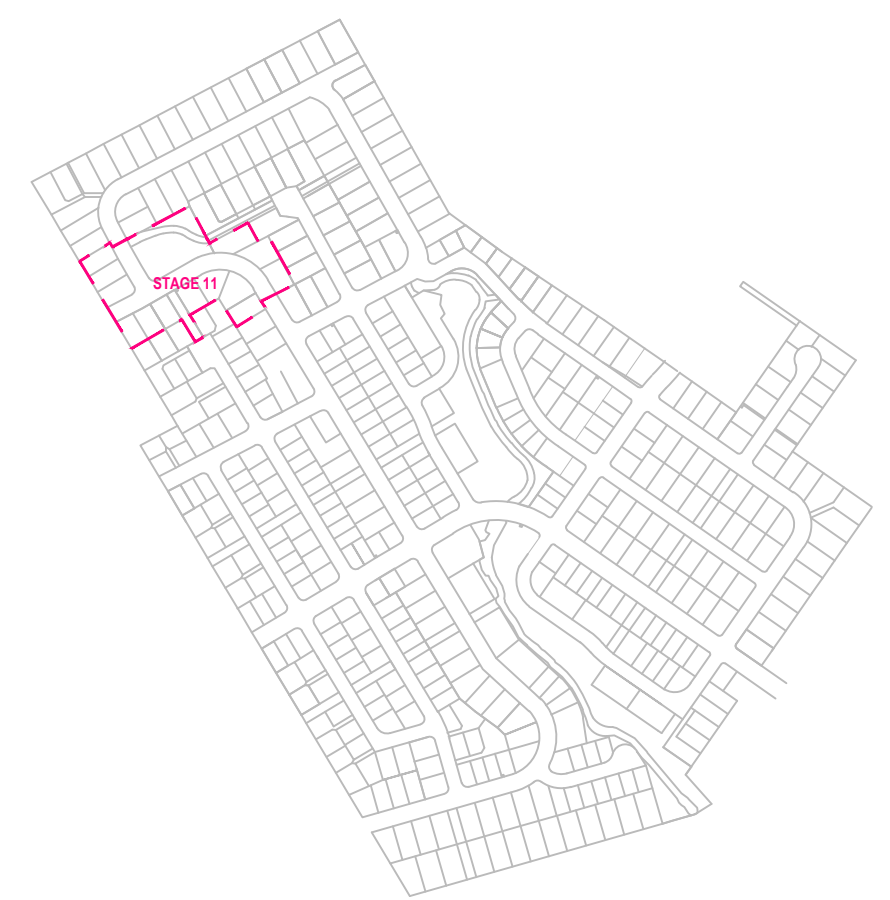


NOTES:

AS BUILT INFORMATION HAS BEEN SUPPLIED BY KBs CONTRACTING & QUARRIES LTD - AUGUST 2014.
 HEIGHTS ARE IN TERMS OF MEAN SEA LEVEL
 ALL LATERALS ARE 20mmØ ID POLY

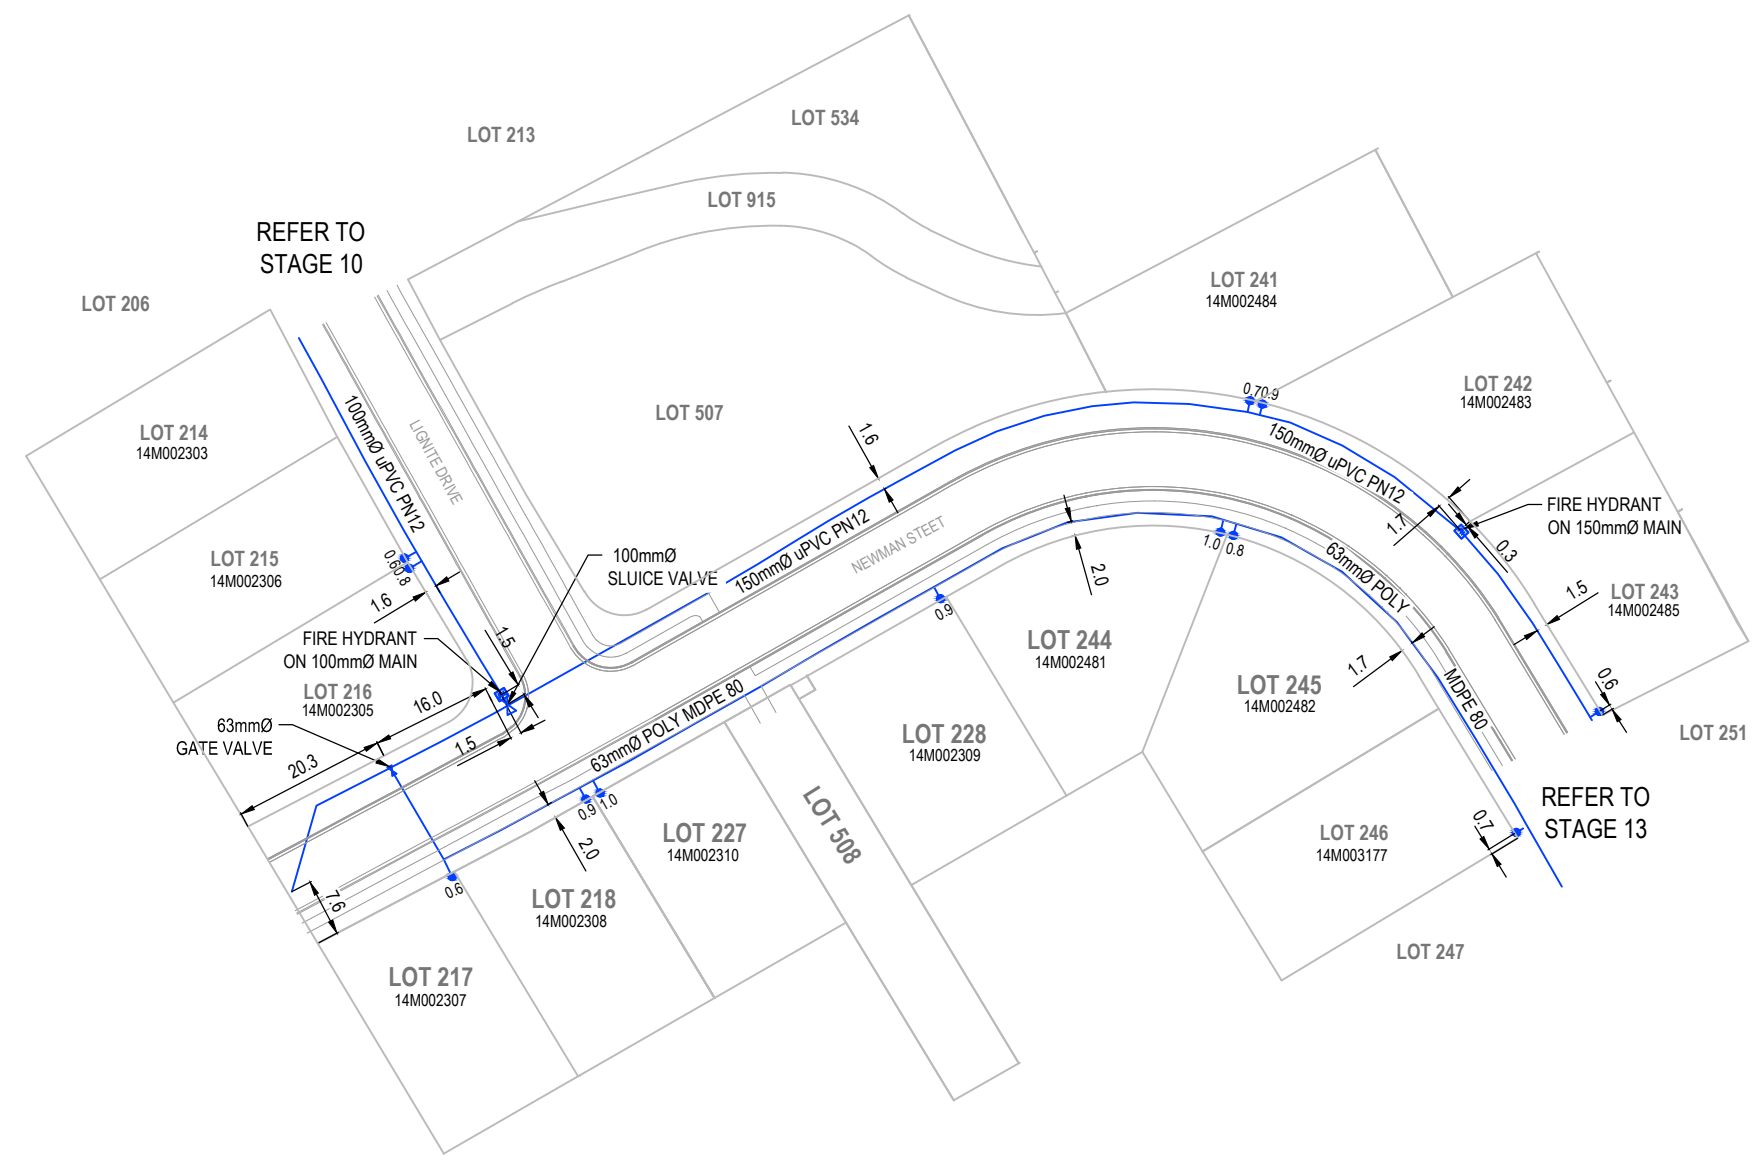

LOCATION PLAN

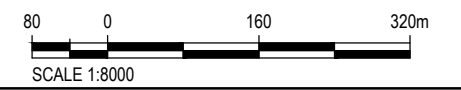

REV	DATE	REVISION DETAILS	APPROVED
A	29.10.14	AS BUILTS ISSUED	B.TOMS

DRAWN	DESIGNED
A.COLUMBUS	M.CROWE
CHECKED	
D.WATSON	
APPROVED	
B.TOMS	DATE 29.10.14
B.TOMS	

PROJECT	AS BUILT
STONEBROOK ROLLESTON	PROJECT No. 224926
TITLE	SCALE AS SHOWN
STAGE 11 WATER AS BUILT	A3
	DRAWING No. DW-LD-S11-AB-W-01
	REV A

AS BUILT	AS BUILT
PROJECT No. 224926	PROJECT No. 224926
SCALE AS SHOWN	SCALE AS SHOWN
A3	A3
DRAWING No. DW-LD-S11-AB-W-01	DRAWING No. DW-LD-S11-AB-W-01
REV A	REV A