



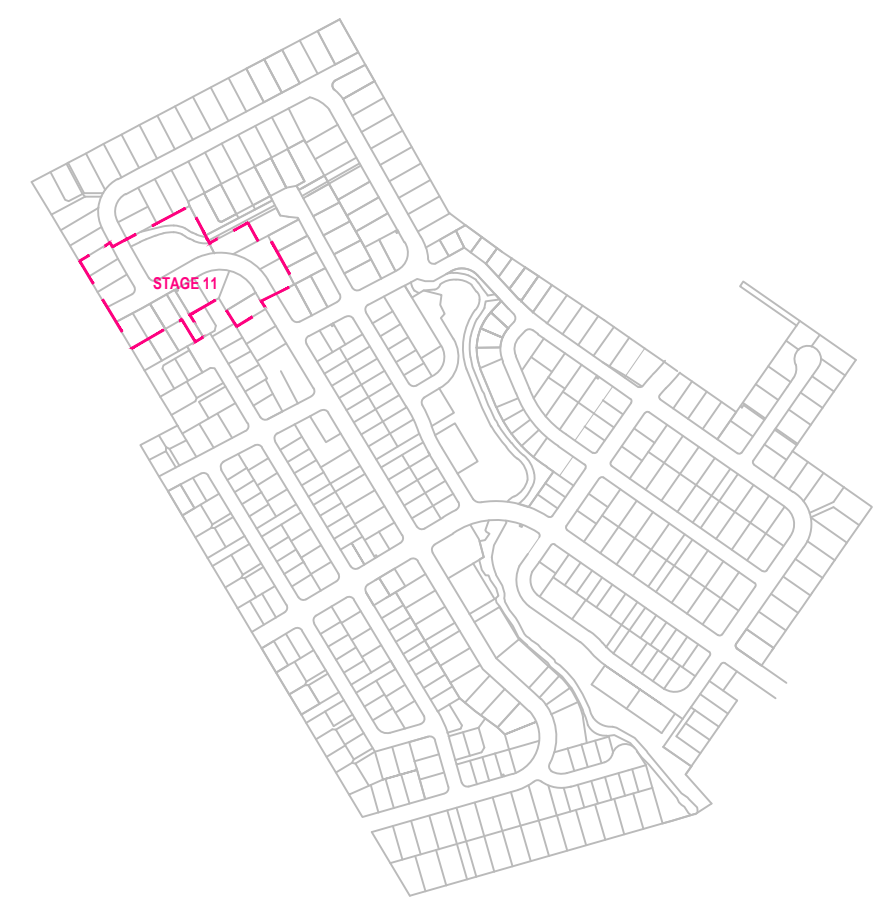

NOTES:

AS BUILT INFORMATION HAS BEEN SUPPLIED BY KBs
 CONTRACTING & QUARRIES LTD - AUGUST 2014.
 HEIGHTS ARE IN TERMS OF MEAN SEA LEVEL
 ALL LATERALS ARE 100mmØ uPVC SN16

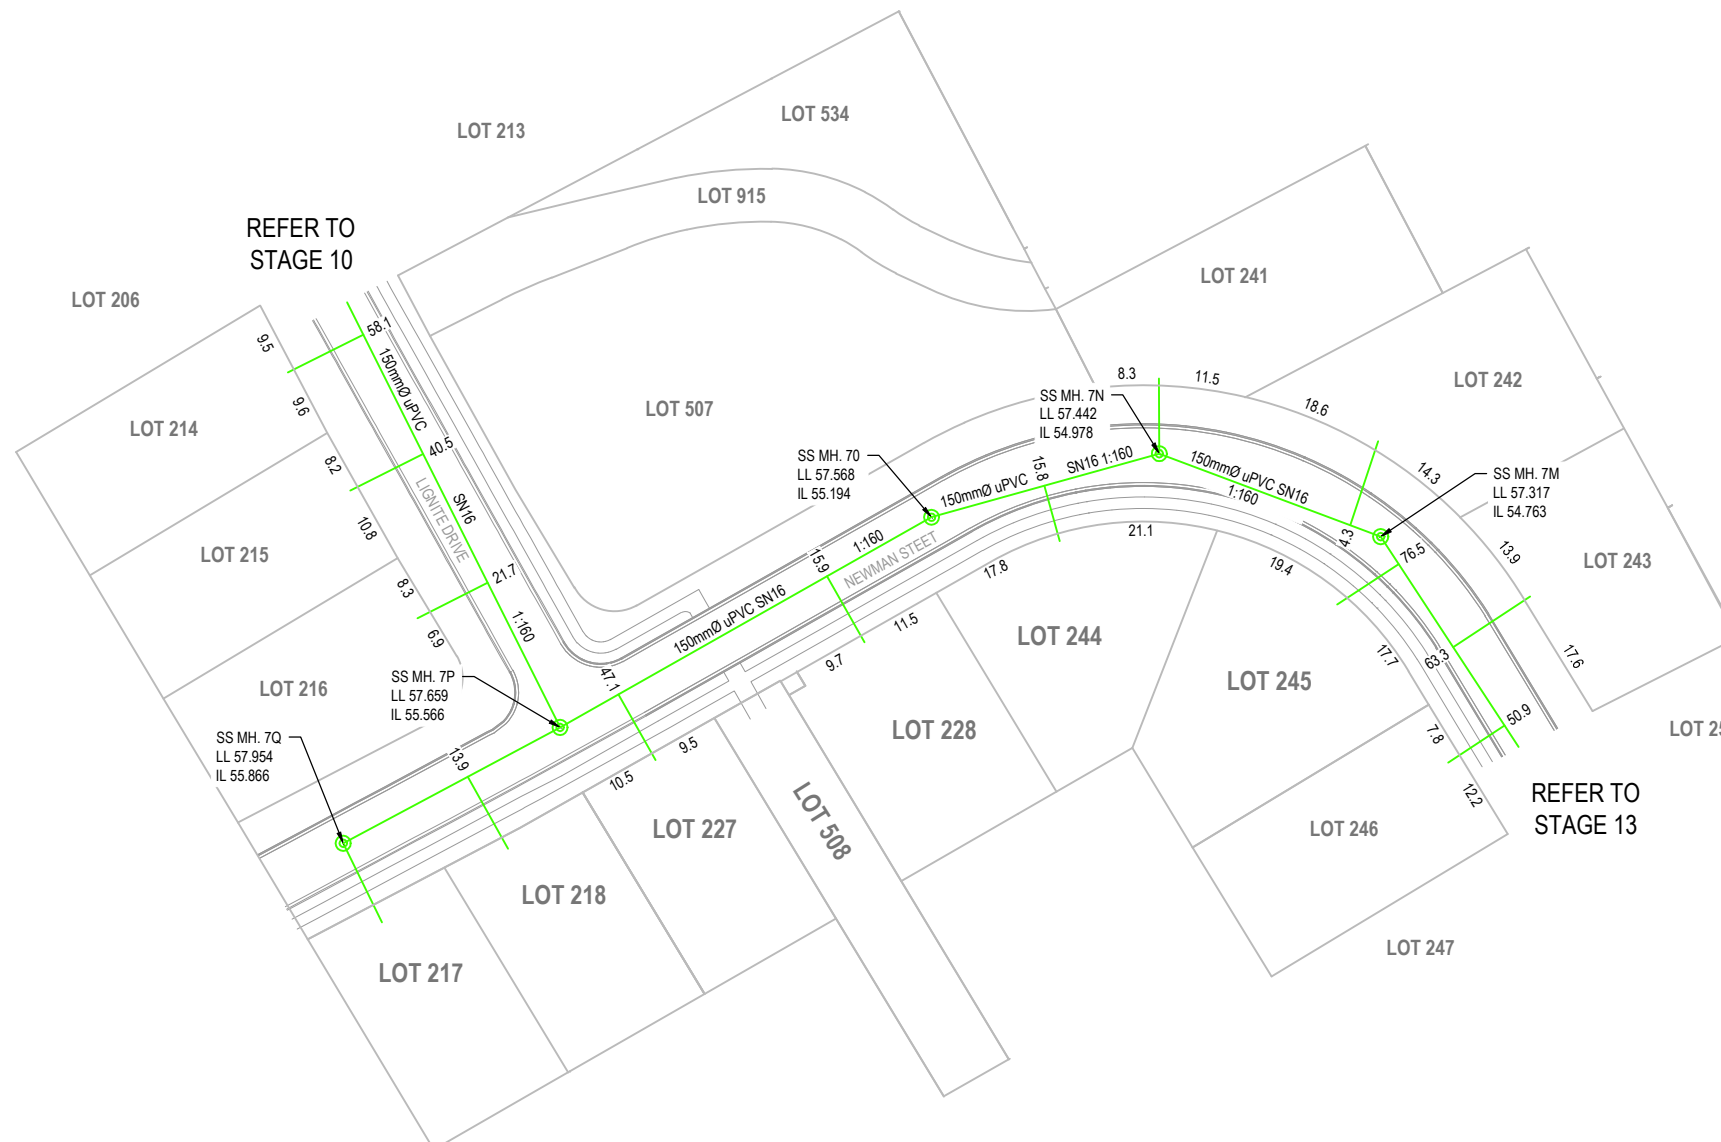

LOCATION PLAN



000000



CLIENT		REV	DATE	REVISION DETAILS	APPROVED	DRAWN	DESIGNED	PROJECT		AS BUILT	
						A.COLUMBUS	M.CROWE	STONEBROOK ROLLESTON		PROJECT No. 224926	
						CHECKED D.WATSON		TITLE		SCALE	SIZE
						APPROVED		STAGE 11 SEWER AS BUILT		AS SHOWN	A3
						B.TOMS	DATE 29.10.14			DRAWING No.	REV
						B.TOMS				DW-LD-S11-AB-SS-01	A
A	29.10.14			AS BUILTS ISSUED	B.TOMS						