



NOTES:


AS BUILT INFORMATION HAS BEEN SUPPLIED BY KBs CONTRACTING & QUARRIES LTD - AUGUST 2014.
 HEIGHTS ARE IN TERMS OF MEAN SEA LEVEL
 ALL LATERALS ARE 100mmØ uPVC SN16

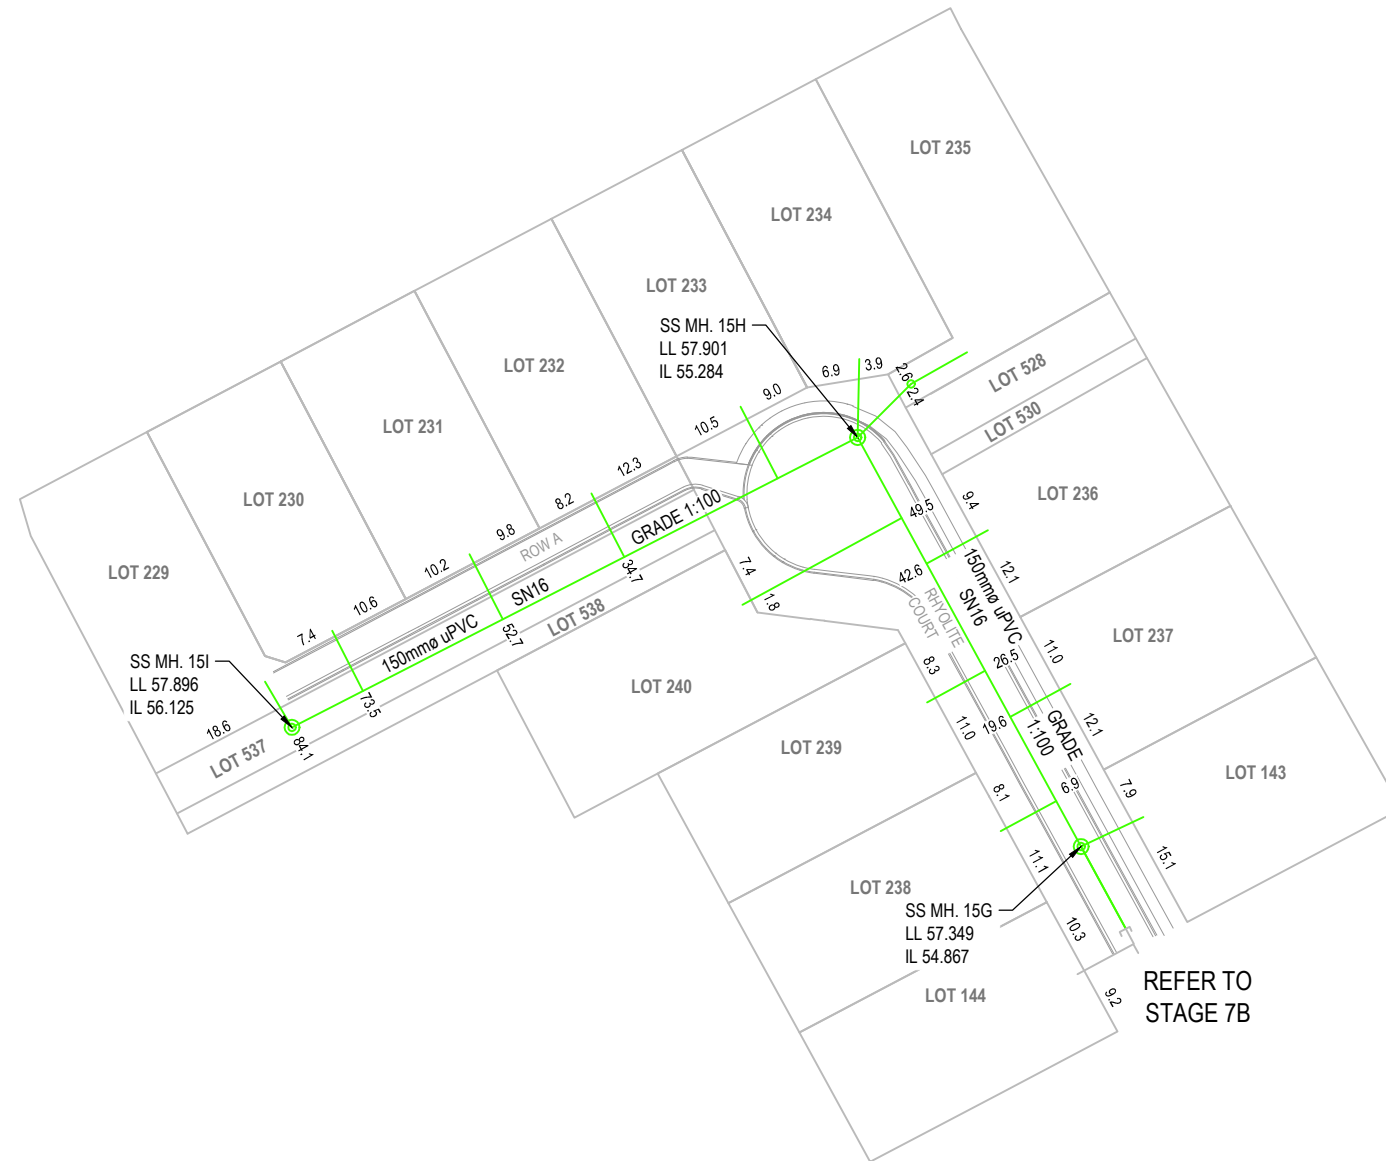

REFER TO STAGE 7B

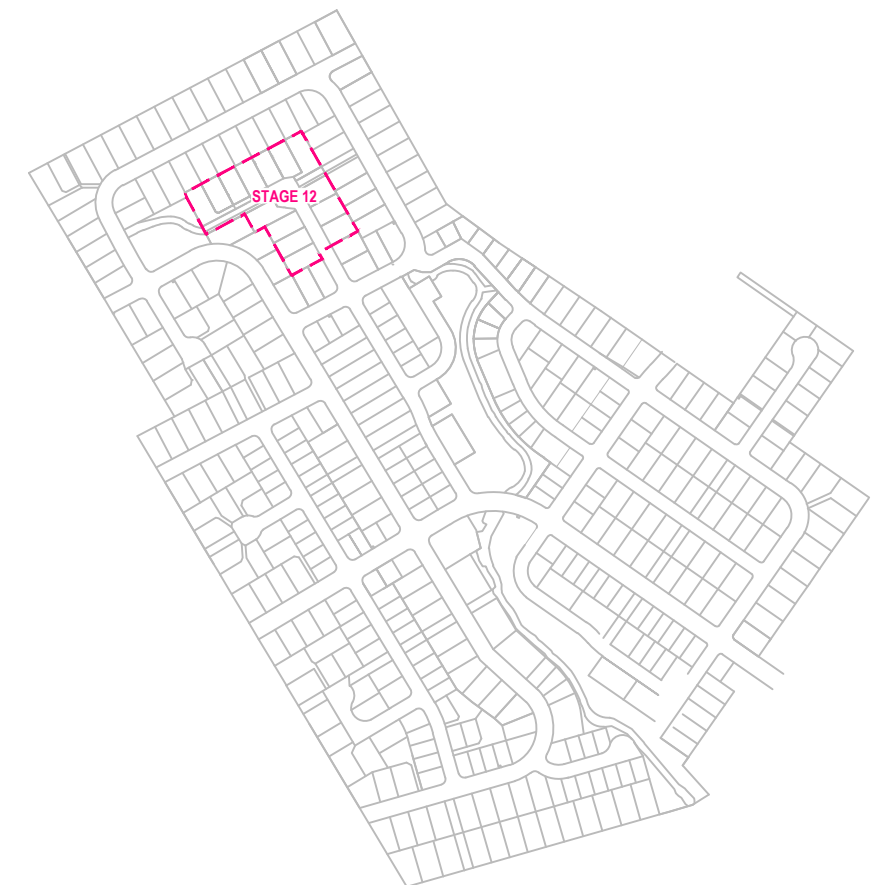

LOCATION PLAN

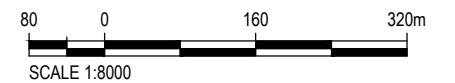

REV	DATE	REVISION DETAILS	APPROVED
A	26.08.14	AS BUILTS ISSUED	B.TOMS

CLIENT	DATE	REVISION DETAILS	APPROVED

DRAWN	DESIGNED
A.COLUMBUS	M.CROWE
CHECKED	
D.WATSON	
APPROVED	
B.TOMS	DATE 26.08.14
B.TOMS	

PROJECT
STONEBROOK ROLLESTON
TITLE
STAGE 12 SEWER AS BUILTS

AS BUILT
PROJECT No. 224926
SCALE AS SHOWN
DRAWING No. DW-LD-S12-AB-SS-01
SIZE A3
REV A

000000