



NOTES:


AS BUILT INFORMATION HAS BEEN SUPPLIED BY KBs CONTRACTING & QUARRIES LTD - AUGUST 2014.
HEIGHTS ARE IN TERMS OF MEAN SEA LEVEL

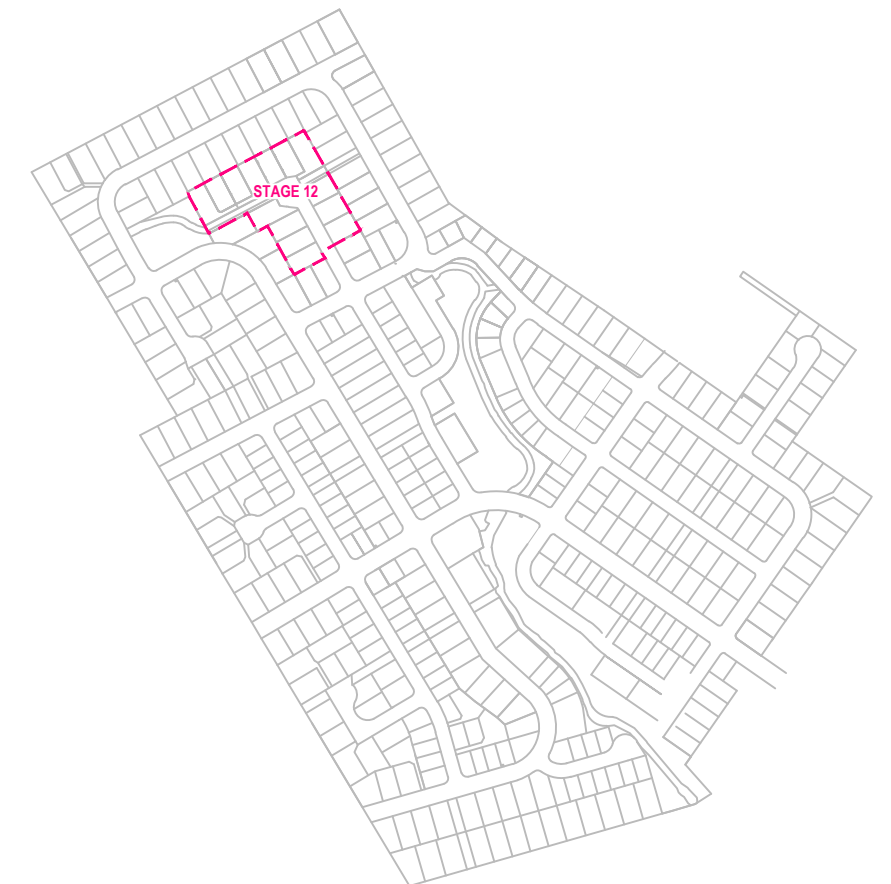

RS = ROAD SUMP IN SDC LOW PROFILE KERB AND CHANNEL

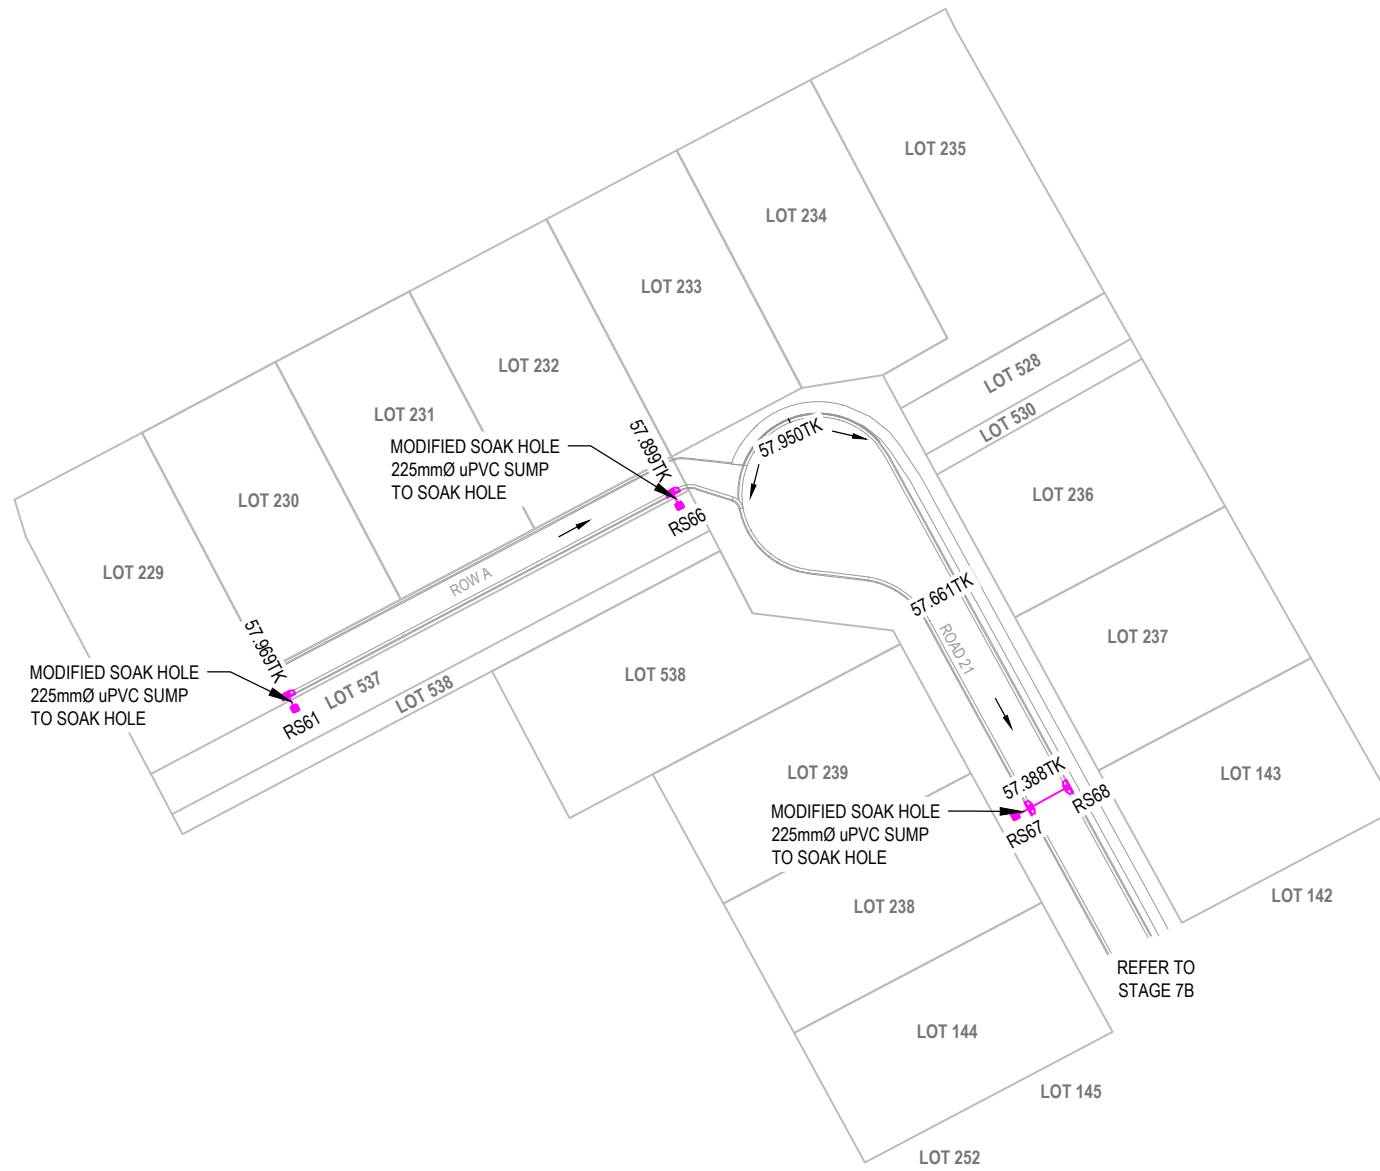

LOCATION PLAN

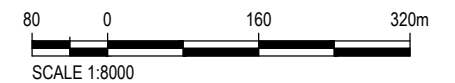

000000



CLIENT

REV	DATE	REVISION DETAILS	APPROVED
A	26.08.14	AS BUILTS ISSUED	B.TOMS

DRAWN	DESIGNED
A.COLUMBUS	M.CROWE
CHECKED	
D.WATSON	
APPROVED	
B.TOMS	DATE 26.08.14
B.TOMS	

PROJECT
STONEBROOK ROLLESTON
TITLE
STAGE 12 STORMWATER AS BUILT

AS BUILT
PROJECT No. 224926
SCALE AS SHOWN
DRAWING No. DW-LD-S12-AB-SW-01
SIZE A3
REV A