



NOTES:
AS BUILT INFORMATION HAS BEEN SUPPLIED BY KBs
CONTRACTING & QUARRIES LTD - JANUARY 2014.
HEIGHTS ARE IN TERMS OF MEAN SEA LEVEL
ALL LATERALS ARE 20mmØ ID POLY

KEY
LOT NUMBER
WATER METER NUMBER
TOBY BOX

LOT XXX
XXMXXXX

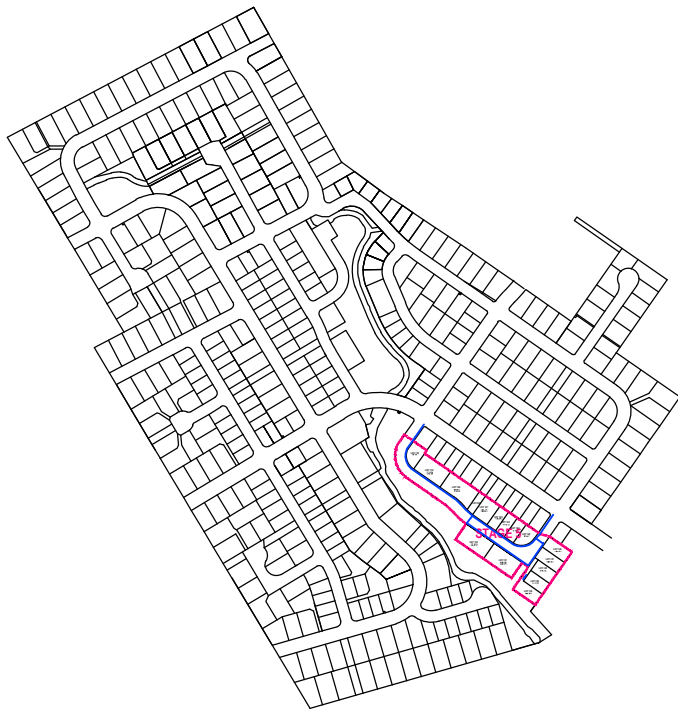

LOCATION PLAN

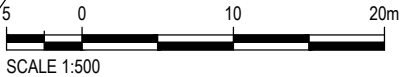

REV	DATE	REVISION DETAILS	APPROVED
A	20.02.14	AS BUILTS ISSUED	

DRAWN	DESIGNED
A.COLUMBUS	M.CROWE
CHECKED	
D.WATSON	
APPROVED	
	DATE
B.TOMS	

PROJECT
STONEBROOK ROLLESTON
TITLE
STAGE 5 WATER AS BUILT

AS BUILT	
PROJECT No.	224926
SCALE	1:1000
DRAWING No.	DW-LD-S2-AB-W-01
SIZE	A3
REV	A