

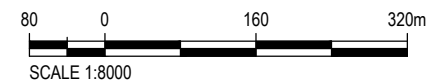


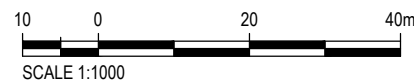

NOTES:

AS BUILT INFORMATION HAS BEEN SUPPLIED BY KBs CONTRACTING & QUARRIES LTD - FEBRUARY 2014.
HEIGHTS ARE IN TERMS OF MEAN SEA LEVEL
ALL LATERALS ARE 20mmØ ID POLY

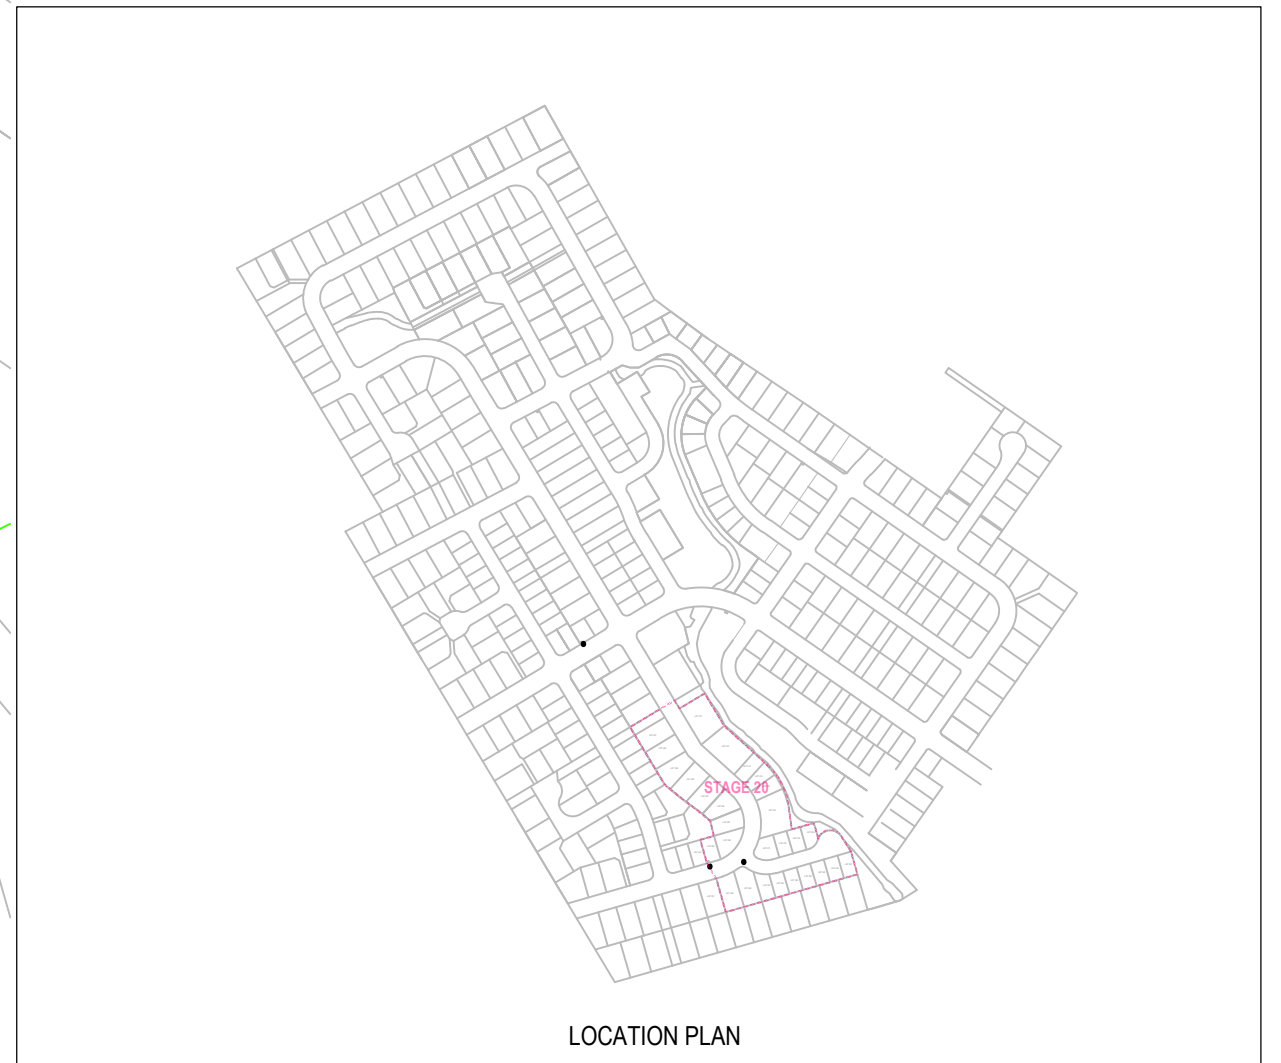

0000000



CLIENT

REV	DATE	REVISION DETAILS	APPROVED
A	07.04.14	AS BUILTS ISSUED	

DRAWN A.GRAY	DESIGNED M.CROWE
CHECKED D.WATSON	
APPROVED	DATE
B.TOMS	

PROJECT	
STONEBROOK ROLLESTON	
TITLE	
STAGE 20 SEWER AS BUILT	

AS BUILT	
PROJECT No. 224926	
SCALE AS SHOWN	SIZE A3
DRAWING No. DW-LD-S2-AB-SS-01	REV A