




NOTES:

AS BUILT INFORMATION HAS BEEN SUPPLIED BY KBs  
CONTRACTING & QUARRIES LTD - FEBRUARY 2014.  
HEIGHTS ARE IN TERMS OF MEAN SEA LEVEL  
ALL LATERALS ARE 20mmØ ID POLY

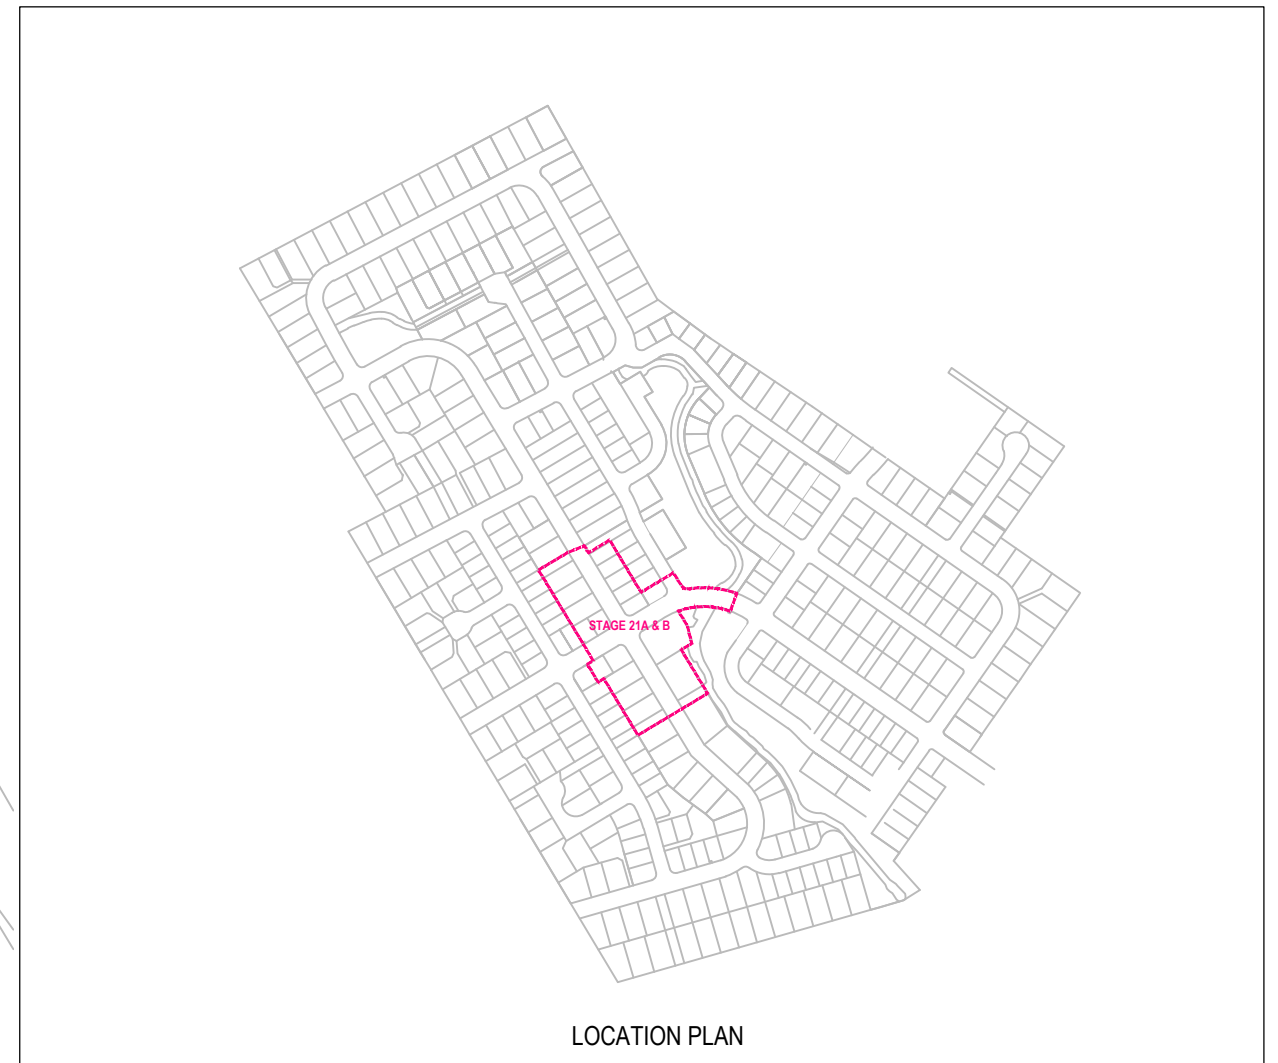

CLIENT	REV	DATE	REVISION DETAILS	APPROVED	DRAWN A.GRAY	DESIGNED M.CROWE	PROJECT		AS BUILT	
					CHECKED D.WATSON		STONEBROOK ROLLESTON		PROJECT No. 224926	
					APPROVED		TITLE		SCALE AS SHOWN	SIZE A3
					B.TOMS		STAGE 21A & B WATER AS BUILT		DRAWING No. DW-LD-S2-AB-W-01	REV A
	A	07.04.14	AS BUILTS ISSUED							