





NOTES:  
 AS BUILT INFORMATION HAS BEEN SUPPLIED BY KBs  
 CONTRACTING & QUARRIES LTD - FEBRUARY 2014.  
 HEIGHTS ARE IN TERMS OF MEAN SEA LEVEL  
 ALL LATERALS ARE 20mmØ ID POLY

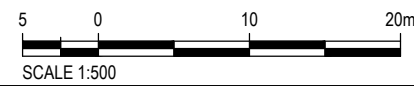

00/00000

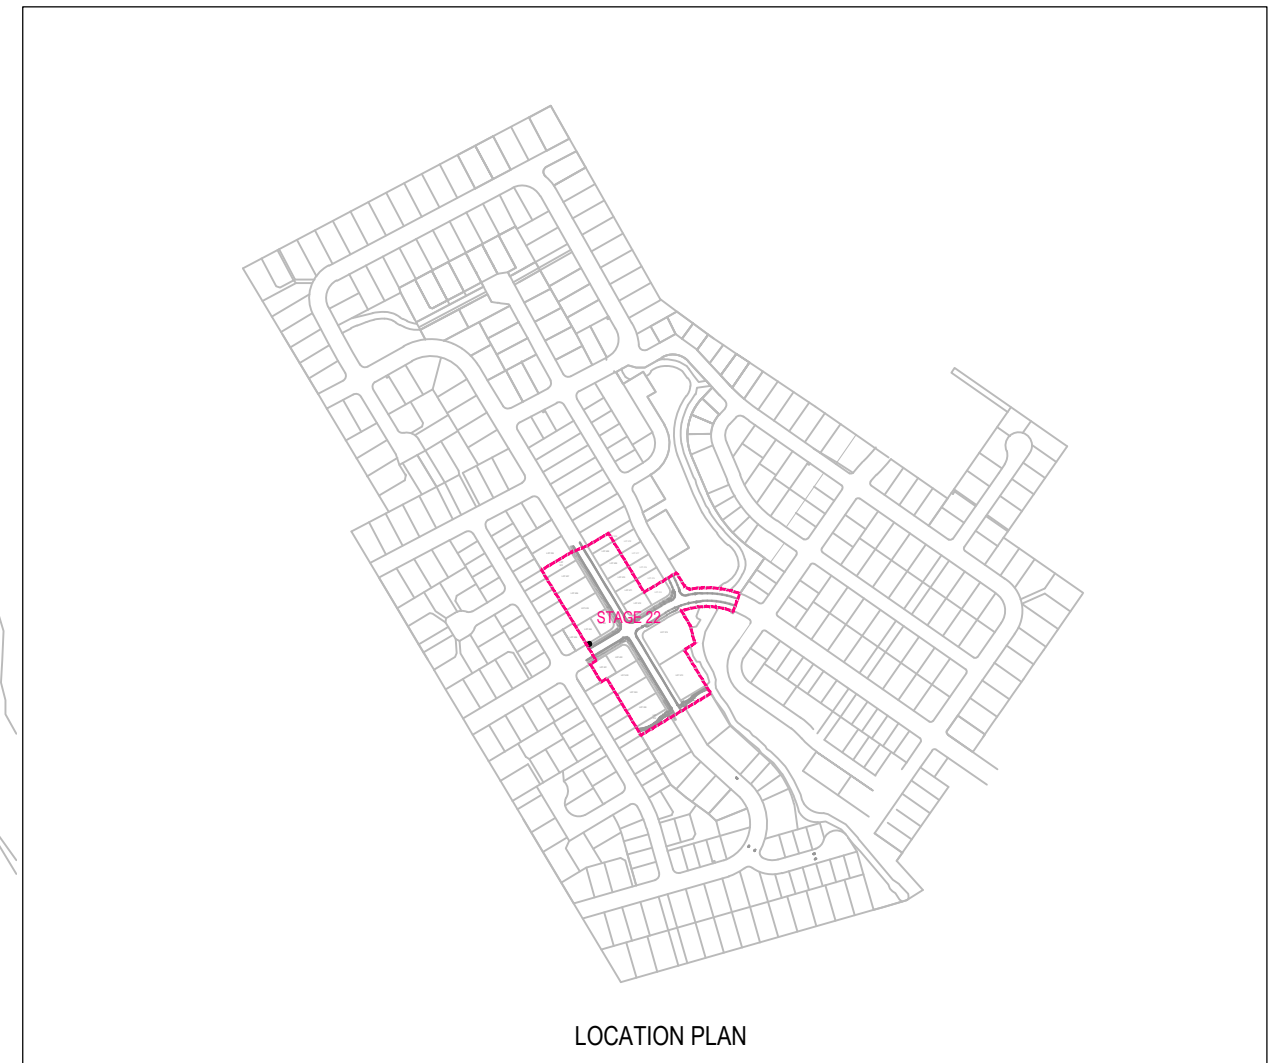

CLIENT

REV	DATE	REVISION DETAILS	APPROVED
A	07.04.14	AS BUILTS ISSUED	

DRAWN	DESIGNED
A.GRAY	M.CROWE
CHECKED	
D.WATSON	
APPROVED	
DATE	
B.TOMS	

PROJECT
STONEBROOK ROLLESTON
TITLE
STAGE 21A & B SEWER AS BUILT

AS BUILT	
PROJECT No.	224926
SCALE	AS SHOWN
SIZE	A3
DRAWING No.	DW-LD-S2-AB-SS-01
REV	A