




NOTE:  
SUBJECT TO COUNCIL ACCEPTANCE

**LEGEND**

- SUB-STAGE Y BOUNDARY
- STORMWATER TO STREET
- DOUBLE SUMP
- SINGLE SUMP
- CORNER SUMP
- SEWER LATERAL TO MAINS
- WATER SUBMAIN

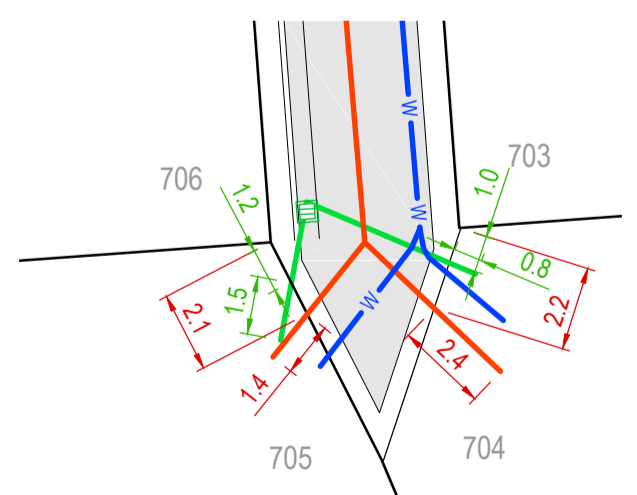

**DETAIL 1**  
1:200

2 0 4 8m  
SCALE 1:200

5 0 10 20m  
SCALE 1:500



REV	DATE	REVISION DETAILS	APPROVED
A	30/05/18	ISSUE FOR INFORMATION	K ASHBY

DRAWN	DESIGNED
R DAWSON	C DOHERTY
CHECKED M CROWE	
APPROVED	
K ASHBY	DATE 30/05/2018
K ASHBY	

PROJECT
PRESTONS PARK
TITLE
AS-BUILT SEWER & STORMWATER STAGE 2 - SUB STAGE Y

PRELIMINARY NOT FOR CONSTRUCTION	
PROJECT No. 235361	
SCALE 1:600	SIZE A1
DRAWING No. AB-PS-S2-SP-06	REV A