
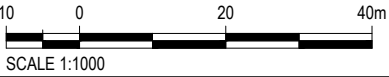


NOTES:  
AS BUILT INFORMATION HAS BEEN SUPPLIED BY KBS  
CONTRACTING & QUARRIES LTD - OCTOBER 2013  
HEIGHTS ARE IN TERMS OF MEAN SEA LEVEL  
ALL LATERALS ARE 100mmØ uPVC

RS = ROAD SUMP IN THE KERB AND CHANNEL

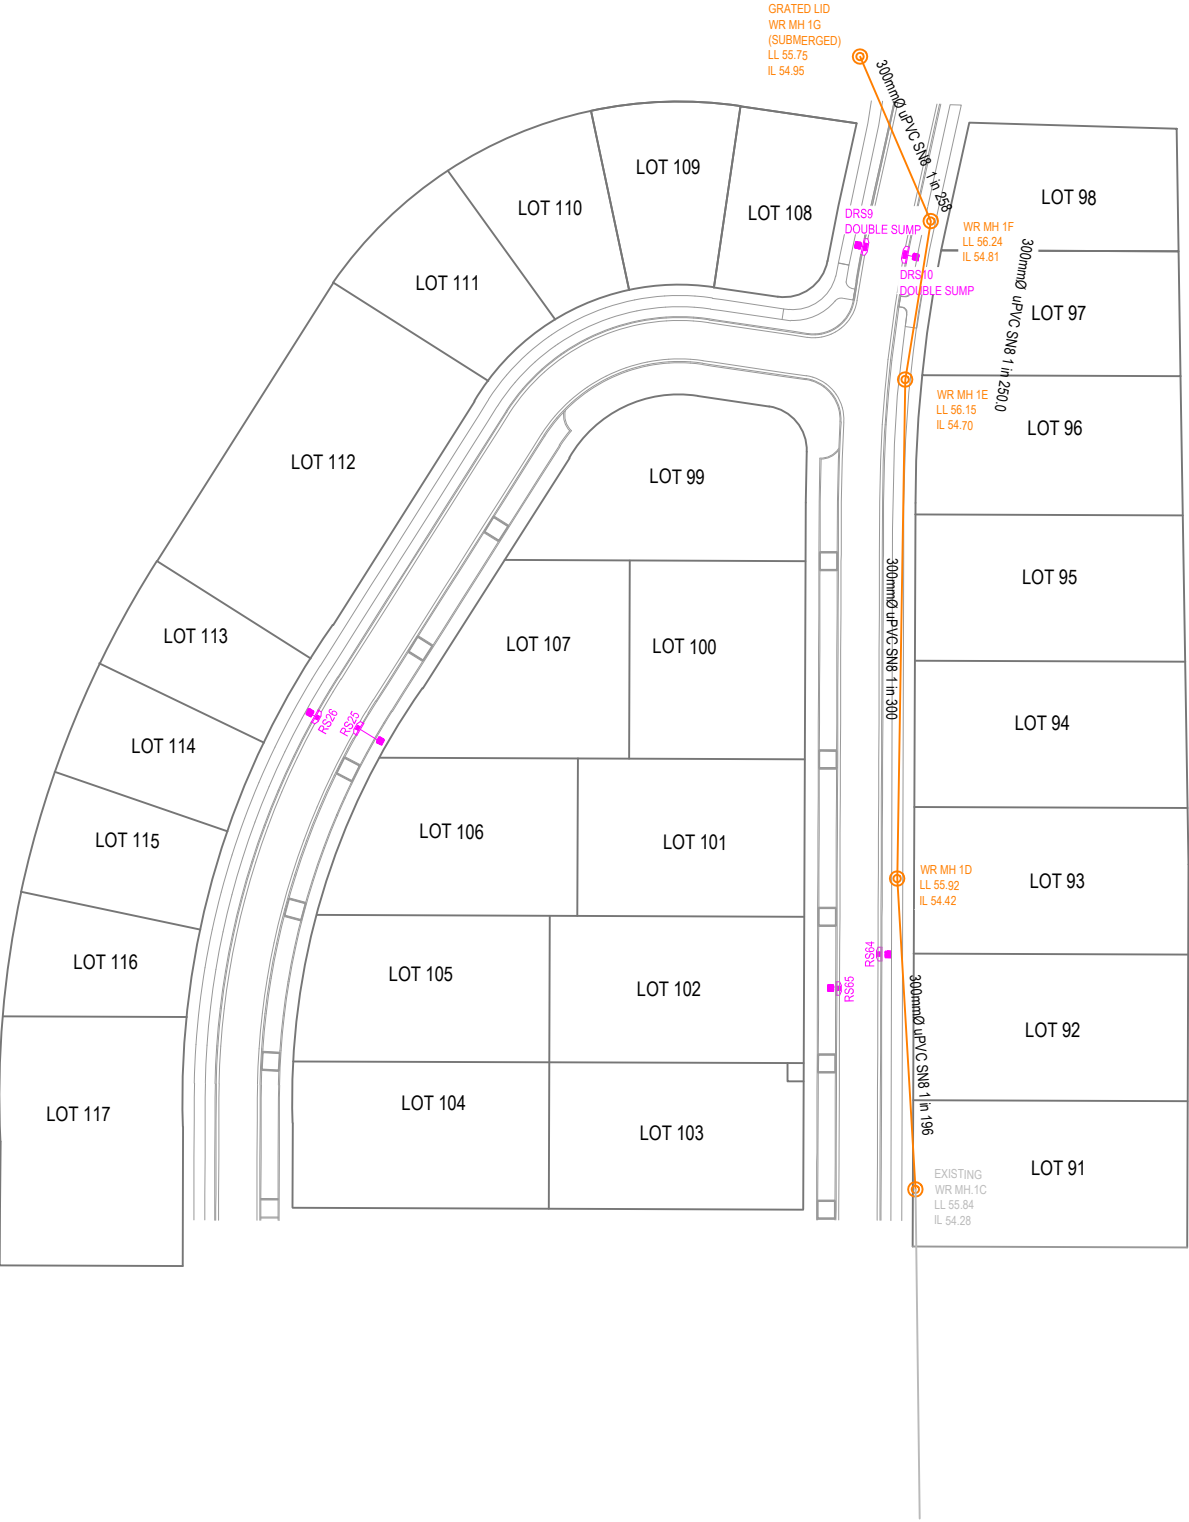

CLIENT		REV	DATE	REVISION DETAILS	APPROVED	DRAWN	DESIGNED	PROJECT		AS BUILT	
						A GRAY	M CROWE	STONEBROOK ROLLESTON		PROJECT No.	
						CHECKED				224926	
						D WATSON		TITLE		SCALE	SIZE
						APPROVED		STAGE 4		1:1000	A3
								STORMWATER AND ROADING		DRAWING No.	REV
								AS BUILTS		DW-LD-S2-AB-SW-01	A
						DATE					
						B TOMS					
		A	01-11-13	AS BUILTS ISSUED							