



NOTES:
 AS BUILT INFORMATION HAS BEEN SUPPLIED BY KBs
 CONTRACTING & QUARRIES LTD - OCTOBER 2013.
 HEIGHTS ARE IN TERMS OF MEAN SEA LEVEL
 ALL LATERALS ARE 20mmØ ID POLY

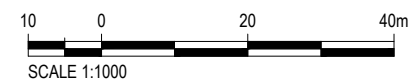

000000

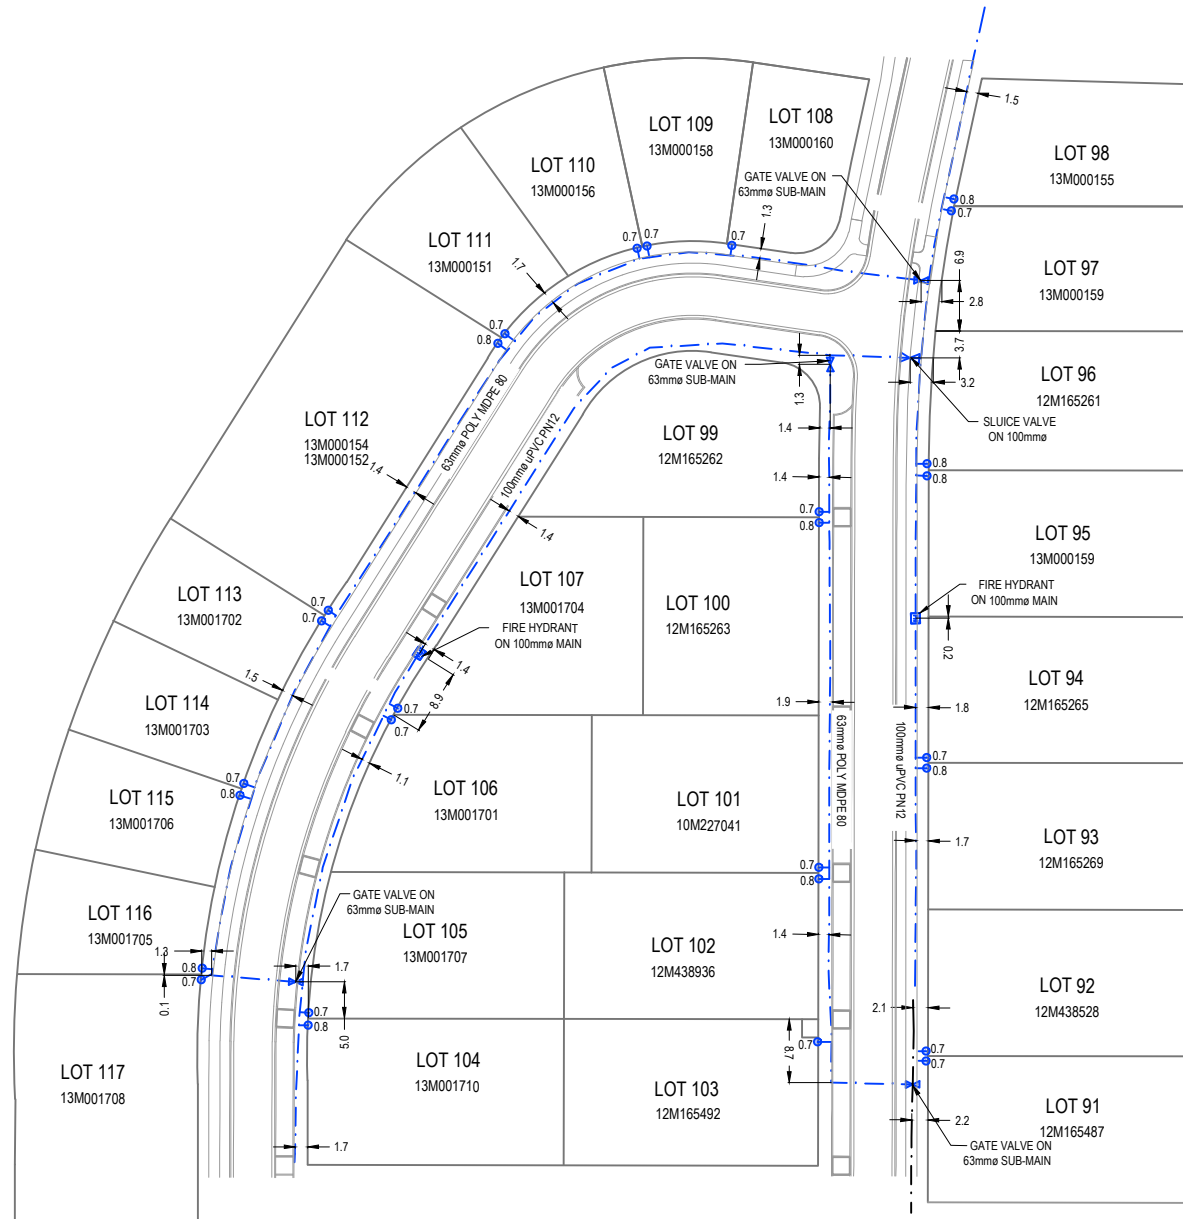

CLIENT		REV	DATE	REVISION DETAILS	APPROVED	DRAWN	DESIGNED	PROJECT	
						A GRAY	M CROWE	STONEBROOK ROLLESTON	
						CHECKED		AS BUILT	
						D WATSON		PROJECT No.	
						APPROVED		224926	
							DATE	SCALE	
								1:1000	
								SIZE	
								A3	
								DRAWING No.	
								DW-LD-S2-AB-W-01	
								REV	
								A	
		A	01-11-13	AS BUILTS ISSUED		B TOMS		TITLE	
								STAGE 4	
								WATER	
								AS BUILT	