

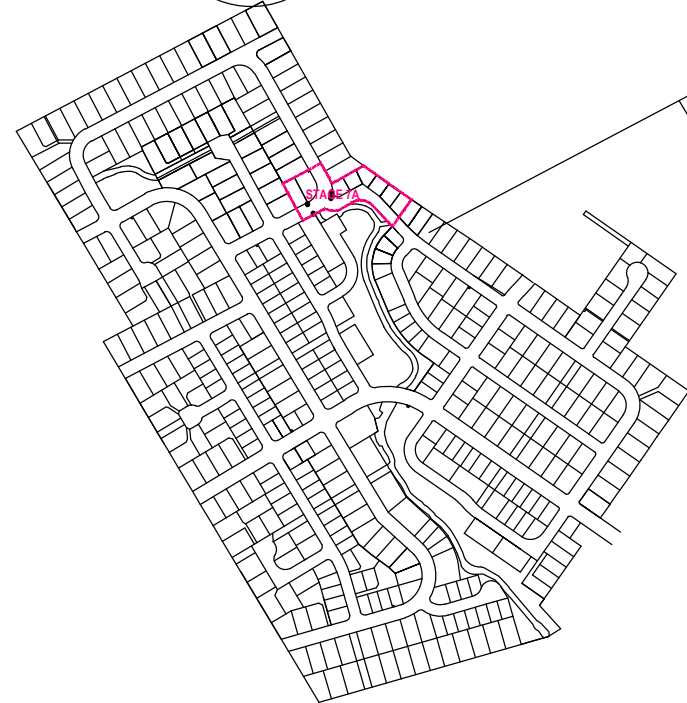


NOTES:
 AS BUILT INFORMATION HAS BEEN SUPPLIED BY KBs
 CONTRACTING & QUARRIES LTD - JANUARY 2014.
 HEIGHTS ARE IN TERMS OF MEAN SEA LEVEL
 ALL LATERALS ARE 20mmØ ID POLY

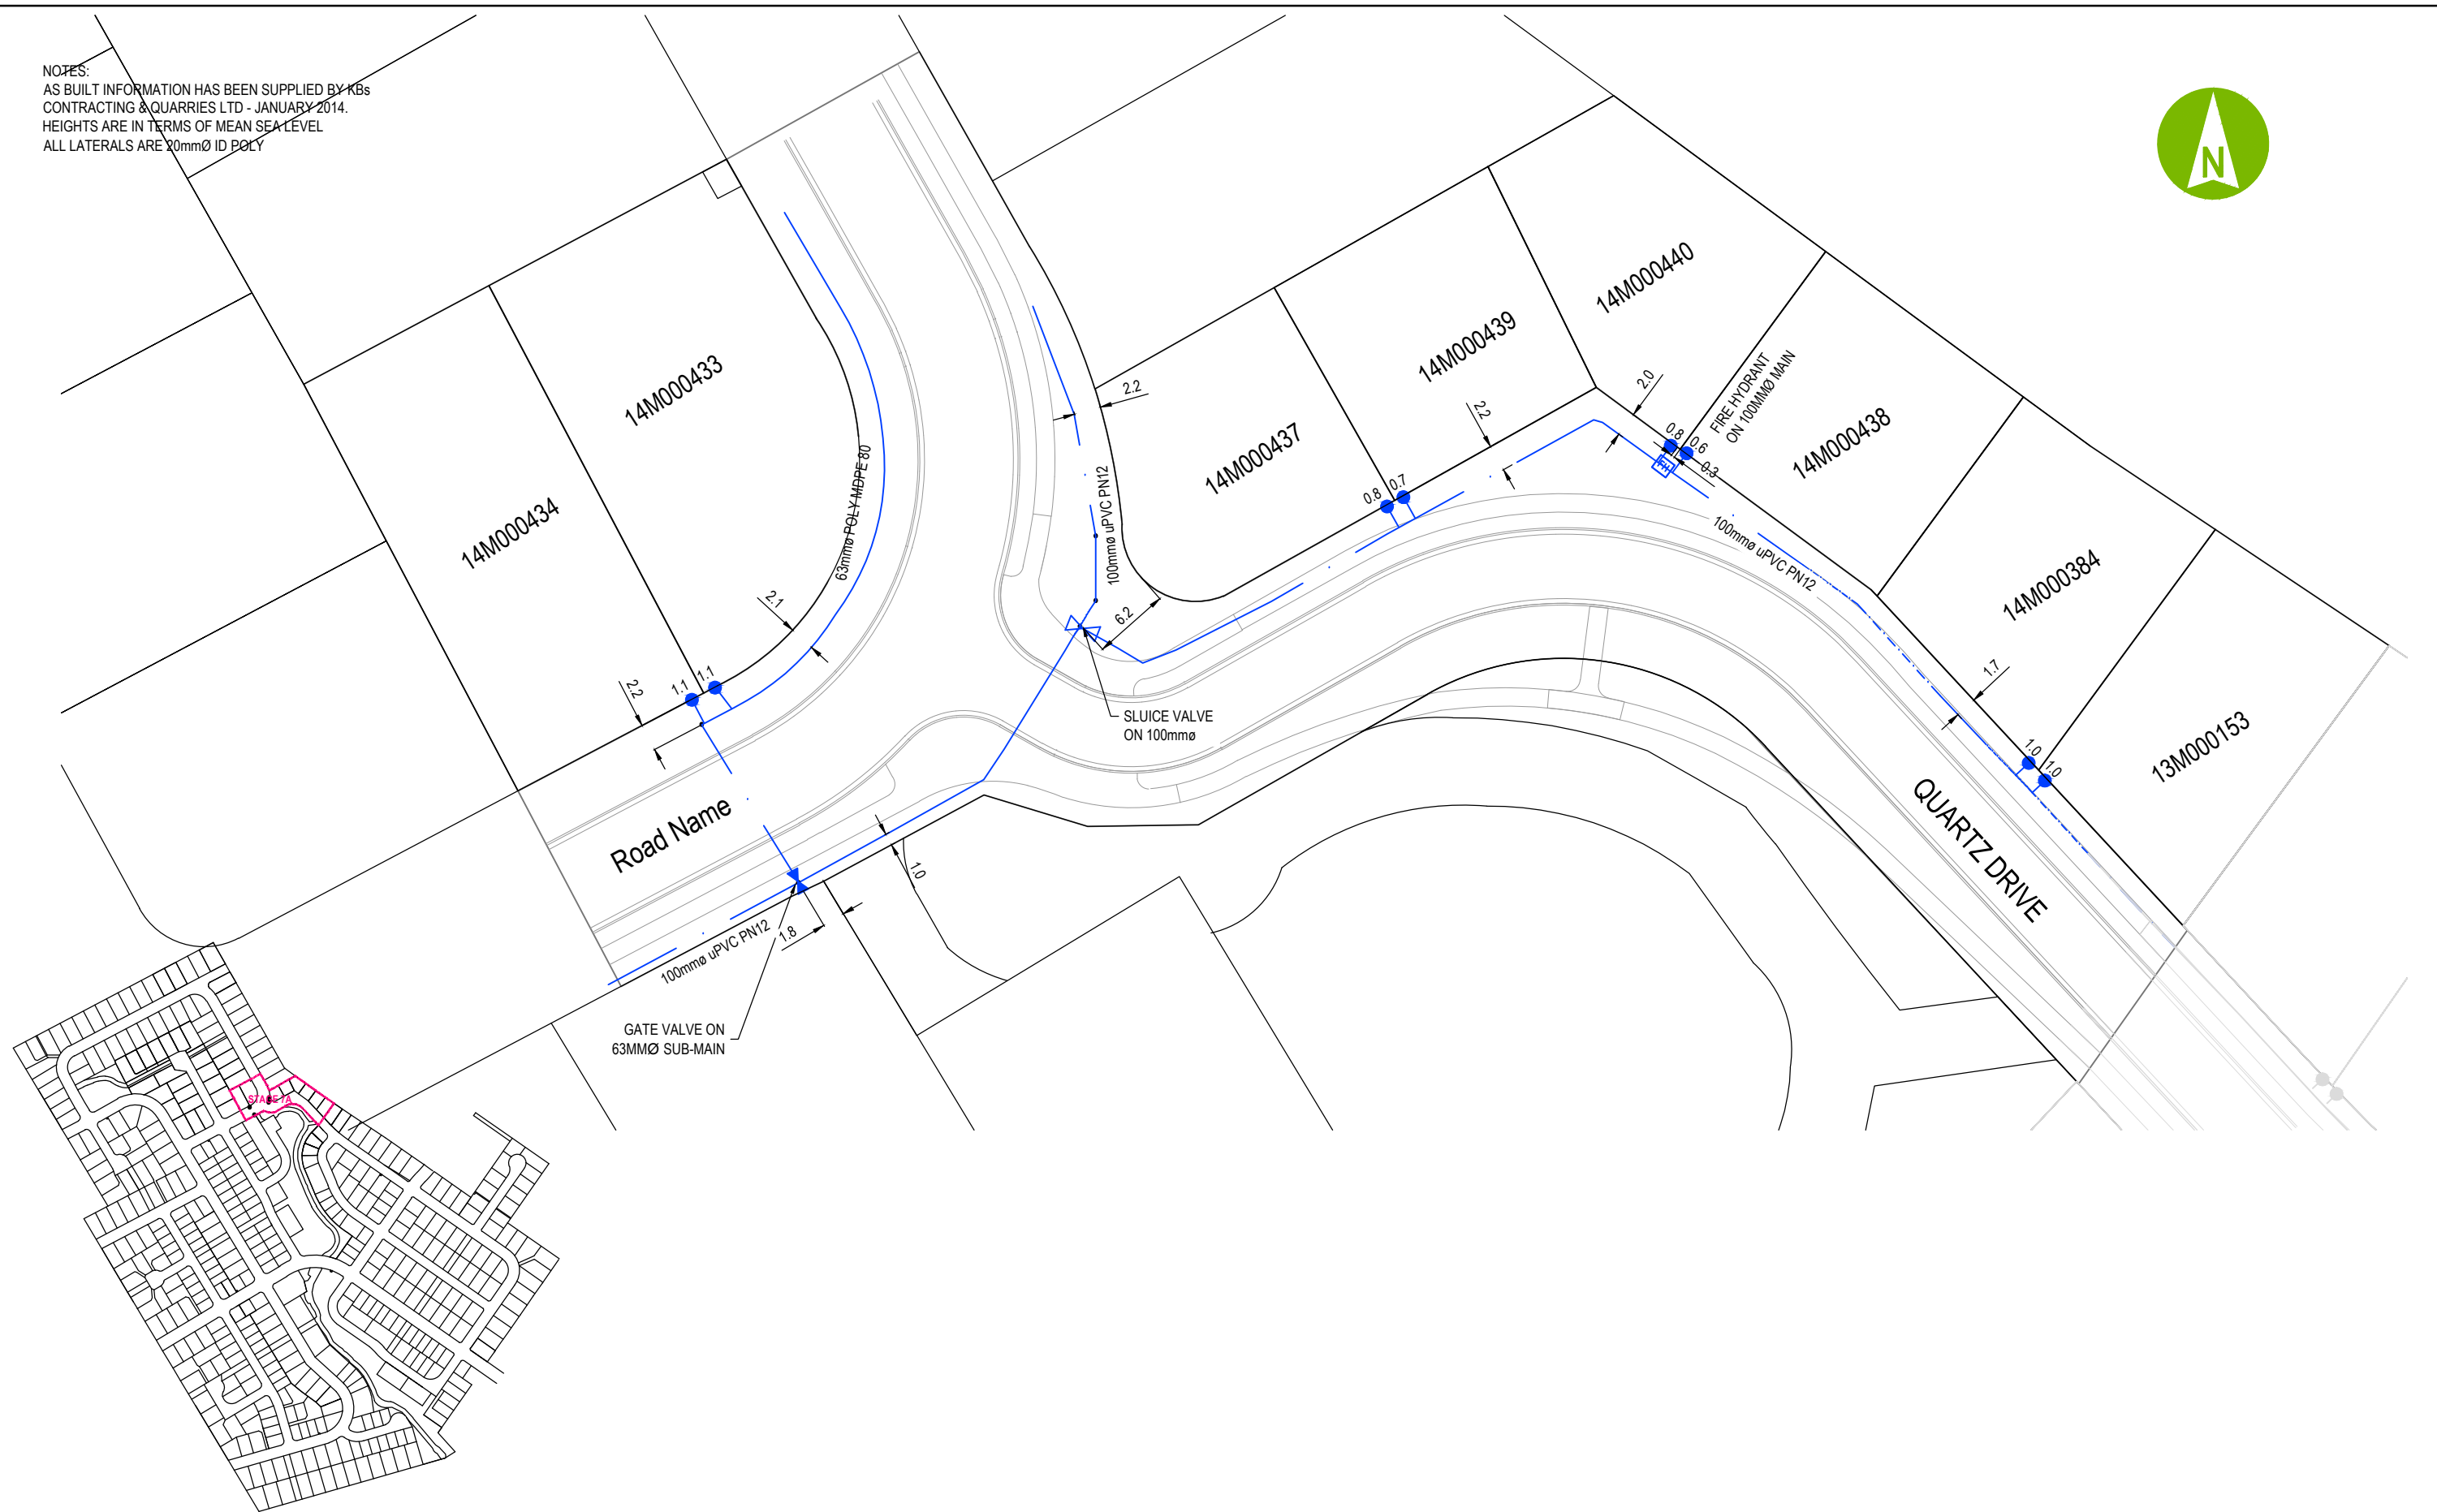

LOCATION PLAN

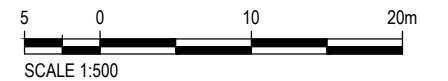

REV	DATE	REVISION DETAILS	APPROVED
A	28.01.14	AS BUILTS ISSUED	

DRAWN	DESIGNED
A.COLUMBUS	M.CROWE
CHECKED	
D.WATSON	
APPROVED	
B.TOMS	

PROJECT
STONEBROOK ROLLESTON
TITLE
STAGE 7A WATER AS BUILT

AS BUILT
PROJECT No. 224926
SCALE 1:500
DRAWING No. DW-LD-S2-AB-W-01
SIZE A3
REV A