

NOTES:
 AS BUILT INFORMATION HAS BEEN SUPPLIED BY KBs
 CONTRACTING & QUARRIES LTD - JANUARY 2014
 HEIGHTS ARE IN TERMS OF MEAN SEA LEVEL
 ALL LATERALS ARE 100mmØ uPVC

DIAGRAM A


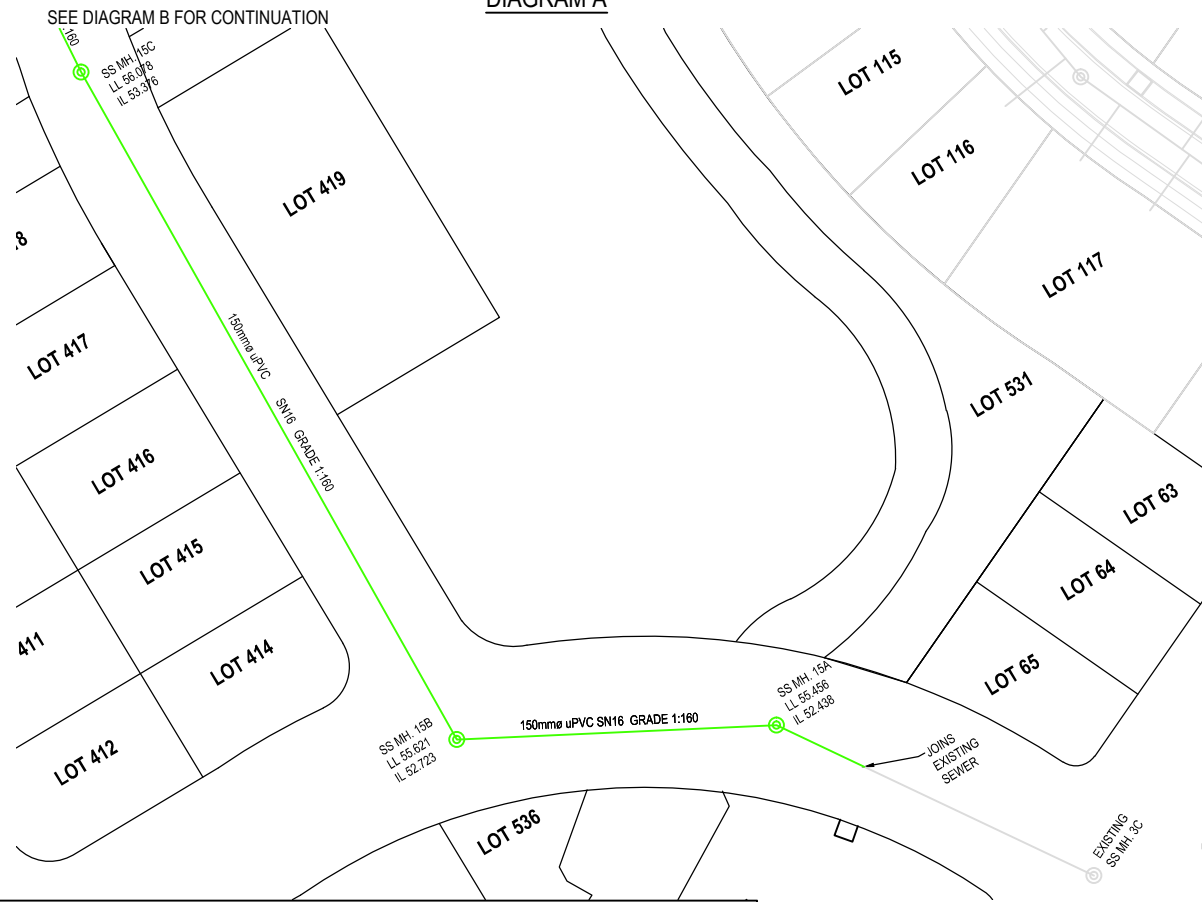


DIAGRAM B



LOCATION PLAN

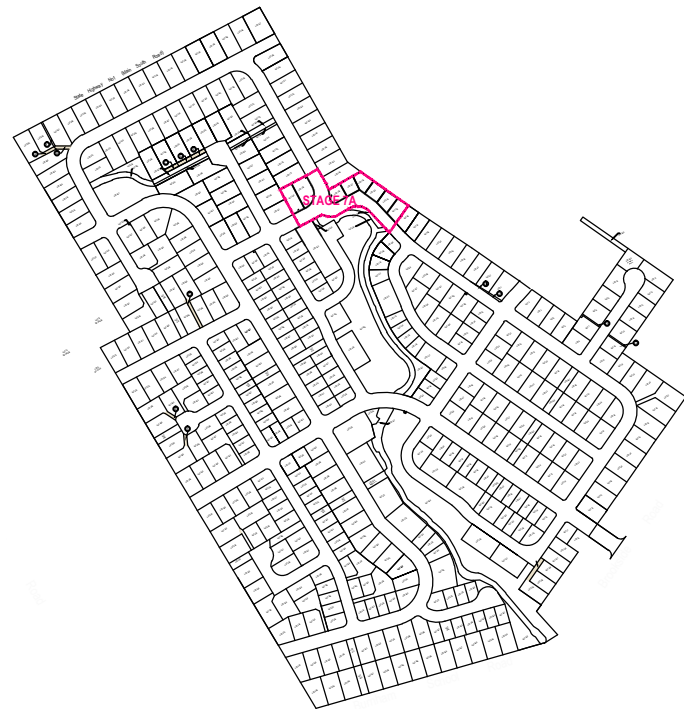

CLIENT

REV	DATE	REVISION DETAILS
A	28.01.14	AS BUILTS ISSUED

APPROVED

DRAWN	DESIGNED
A COLUMBUS	M CROWE
CHECKED	
D WATSON	
APPROVED	
	DATE
B TOMS	

PROJECT

STONEBROOK ROLLESTON
TITLE
STAGE 7A SEWER AS BUILTS

AS BUILT

PROJECT No.	224926
SCALE	1:1000
DRAWING No.	DW-LD-S2-AB-SS-01
SIZE	A3
REV	A