



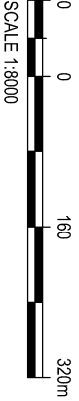

ALL LATERALS ARE 20mmØ ID POLY

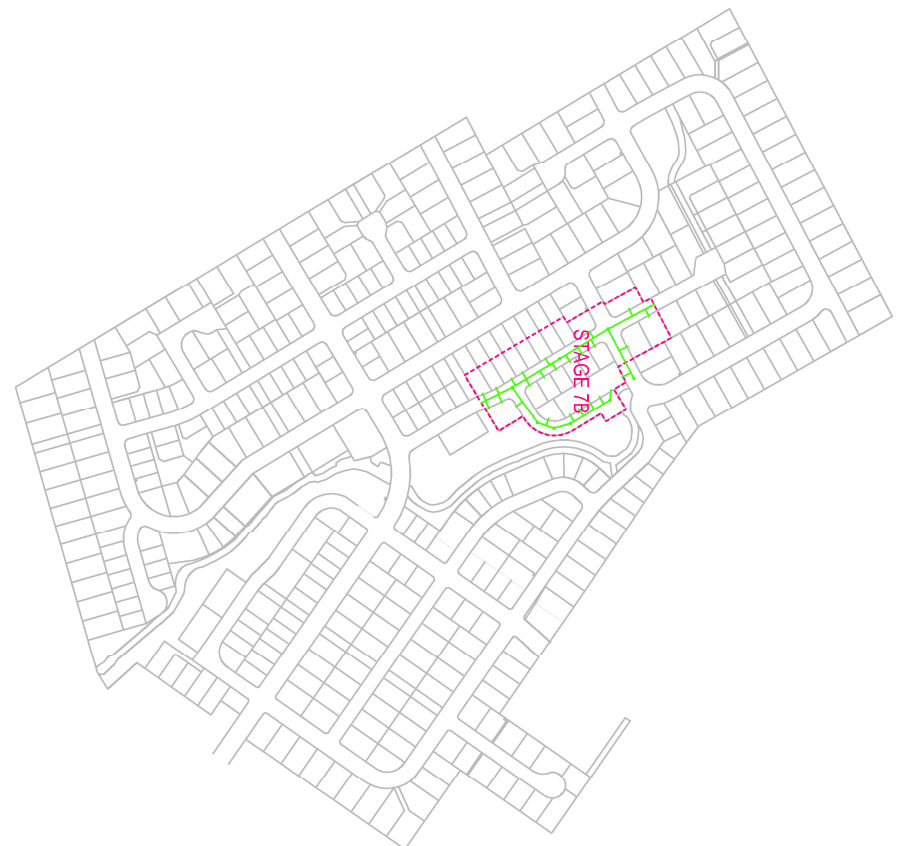

REV	DATE	REVISION DETAILS	APPROVED
A	28.02.14	AS BUILT'S ISSUED	B.TOW'S