

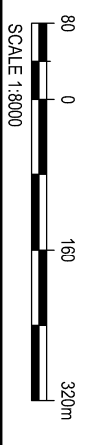


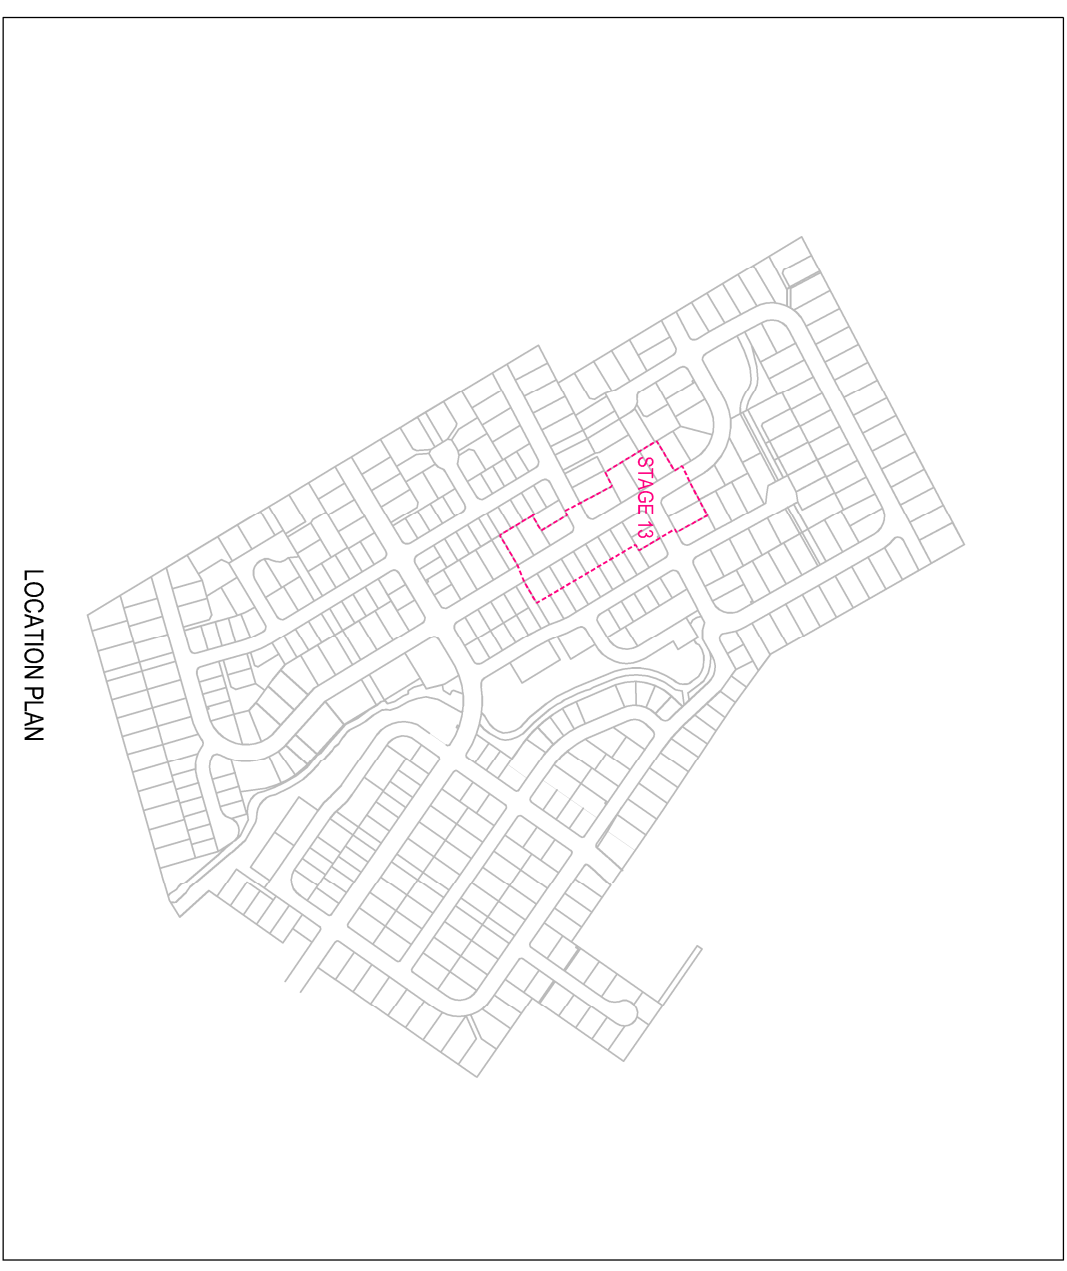

NOTES:
 AS BUILT INFORMATION HAS BEEN SUPPLIED BY KBS
 CONTRACTING & QUARRIES LTD - FEBRUARY 2014.
 HEIGHTS ARE IN TERMS OF MEAN SEA LEVEL
 ALL LATERALS ARE 20mmØ ID POLY

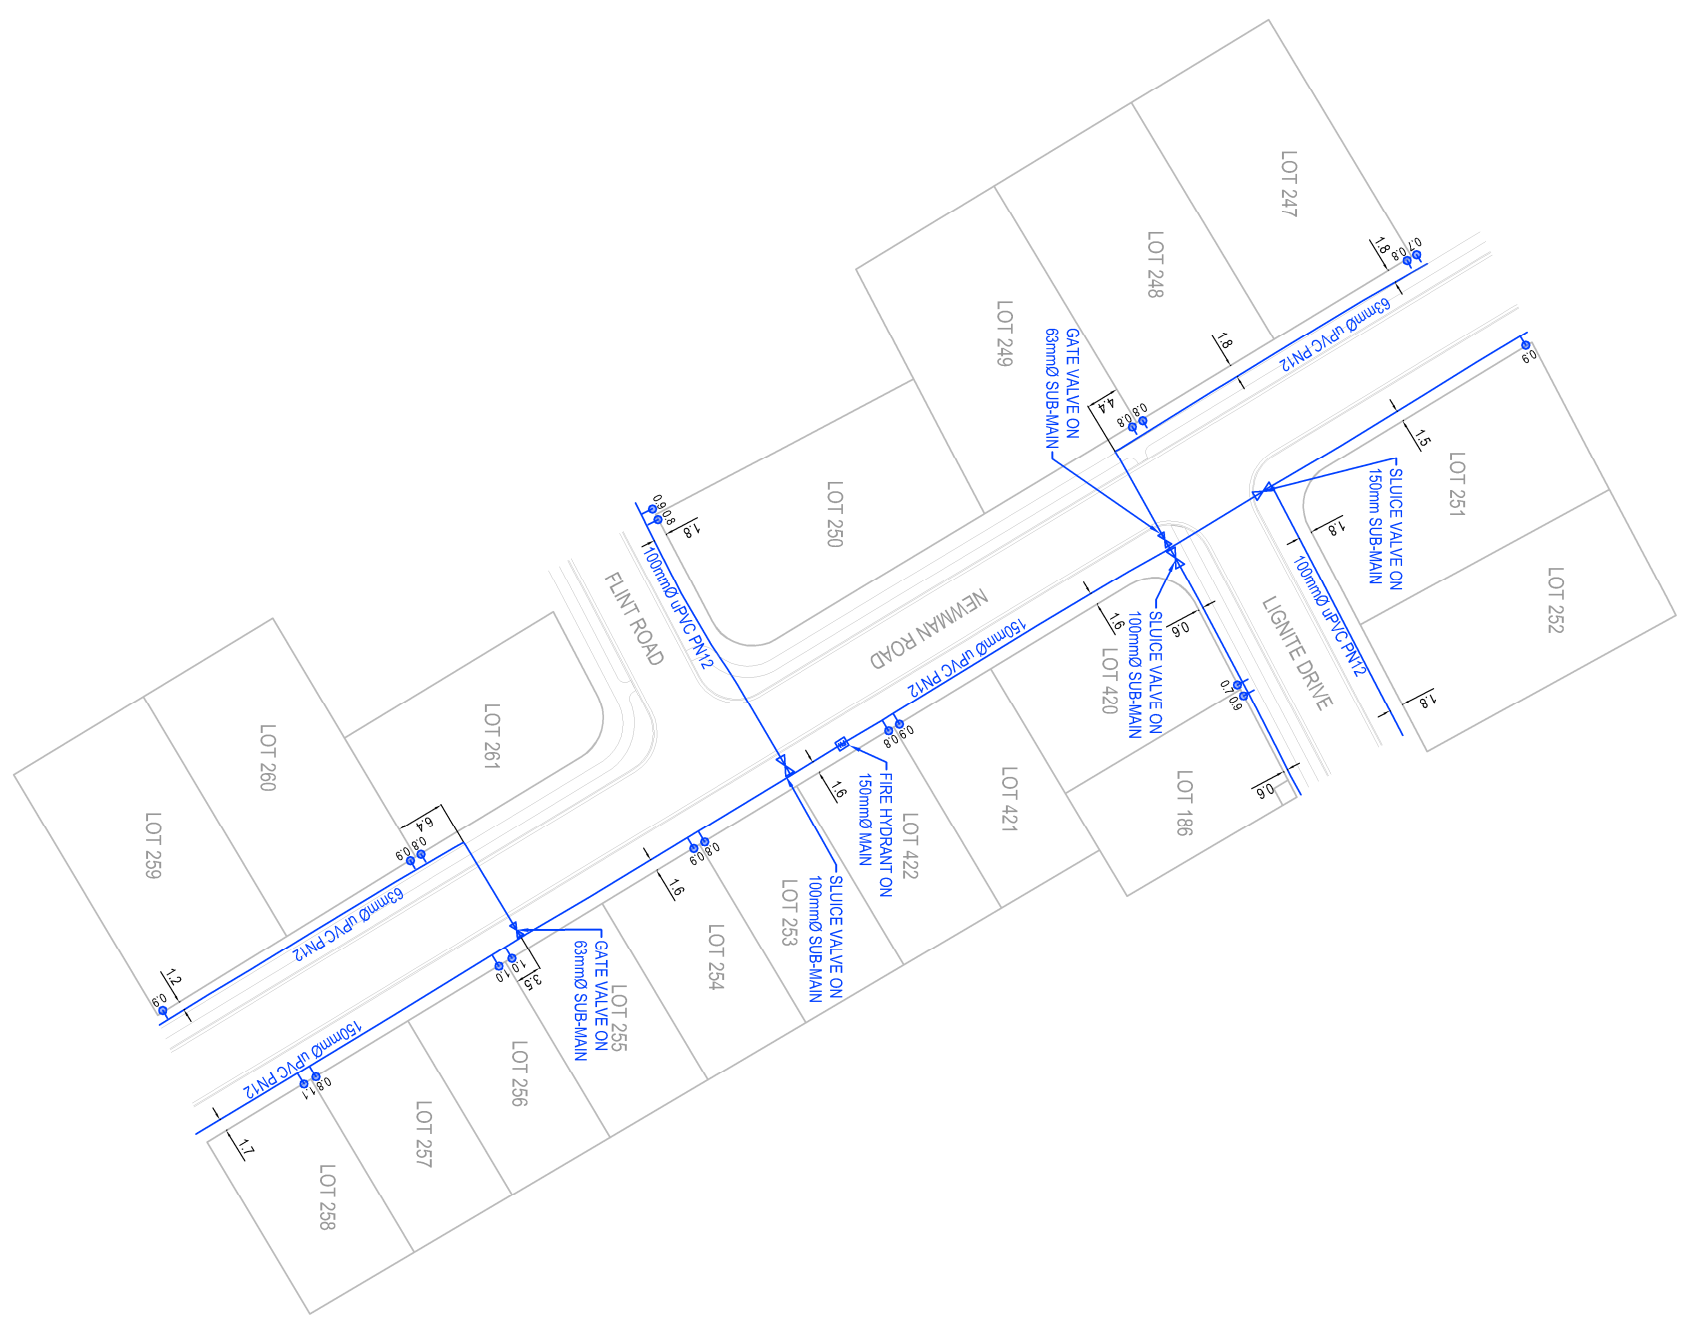

CLIENT		REVISION DETAILS		APPROVED	DRAWN	CHECKED	DESIGNED	PROJECT	AS BUILT
		REV	DATE		A GRAY	D WATSON	M CROWE	STONEBROOK ROLLESTON	PROJECT No. 224926
					B TOMS	B TOMS	DATE 28.02.14	STAGE 13 WATER AS BUILT	SCALE AS SHOWN
		A	28.02.14		B TOMS	B TOMS			DRAWING No. 224926
									SIZE A3
									REV A