






SCALE 1:5000

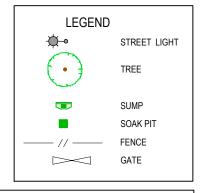

SURVEY ORIGIN DATA

VERTICAL ELEVATIONS ARE IN TERMS OF LYTTELTON VERTICAL

DATUM 1937. THE ORIGIN OF LEVELS IS ACE5 RL 57.679m.

HORIZONTAL COORDINATES ARE IN TERMS OF NZ GEODETIC DATUM 2000, MOUNT PLEASANT 2000 CIRCUIT. ORIGIN OF SURVEY: IS I DP361539 (798707.47mN 370018.15mE)

THE BOUNDARIES ON THIS PLAN SHOULD NOT BE RELIED UPON BY THEMSELVES, BUT MUST BE VERIFIED AGAINST THE LEGAL SURVEY PLAN BOUNDARIES TO CONFIRM THEIR ACCURACY.



CLIENT


REV	DATE	REVISION DETAILS	APPROVED	DRAWN	DESIGNED	
				R. DAWSON	M.CROWE	
				CHECKED		
				K ASHBY		
				APPROVED		
				B TOMS	DATE 29/10/2018	
				D TOM	20//0/20/0	
Α	29/10/18	ISSUE FOR INFORMATION	B TOMS	B.TOMS		

STONEBROOK ROLLESTON SITE LEVELS LOTS 12-14


PRELIMINARY NOT FOR CONSTRUCTION 224926 1:400 DW-SU-SP-003





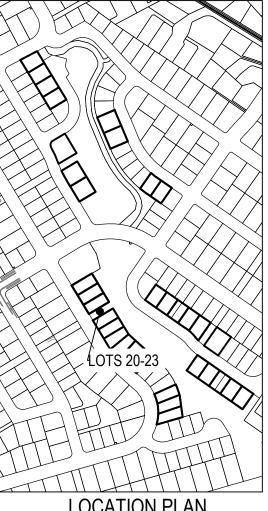

LOCATION PLAN SCALE 1:5000

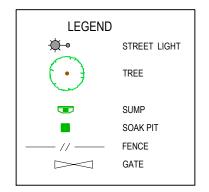

DW-SU-SP-005

SURVEY ORIGIN DATA

VERTICAL ELEVATIONS ARE IN TERMS OF LYTTELTON VERTICAL

DATUM 1937. THE ORIGIN OF LEVELS IS ACE5 RL 57.679m.

HORIZONTAL COORDINATES ARE IN TERMS OF NZ GEODETIC DATUM 2000, MOUNT PLEASANT 2000 CIRCUIT.

ORIGIN OF SURVEY: IS I DP361539 (798707.47mN 370018.15mE)

THE BOUNDARIES ON THIS PLAN SHOULD NOT BE RELIED UPON BY THEMSELVES, BUT MUST BE VERIFIED AGAINST THE LEGAL SURVEY PLAN BOUNDARIES TO CONFIRM THEIR ACCURACY.



					SCALE 1:400	
REV	DATE	REVISION DETAILS	APPROVED	DRAWN	DESIGNED	П
				R. DAWSON	M.CROWE	
				CHECKED		
				K ASHBY		
				APPROVED		
				В ТОМ	DATE 29/10/2018	
				D TOIVIC	23/10/2010	
Α	29/10/18	ISSUE FOR INFORMATION	B TOMS	B.TOMS		


PRELIMINARY NOT FOR CONSTRUCTION STONEBROOK ROLLESTON 224926 1:400 SITE LEVELS LOTS 20-23







LOCATION PLAN SCALE 1:5000

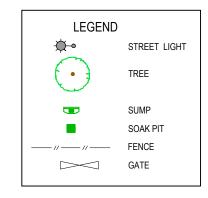

SURVEY ORIGIN DATA
VERTICAL ELEVATIONS ARE IN TERMS OF LYTTELTON VERTICAL

DATUM 1937. THE ORIGIN OF LEVELS IS ACE5 RL 57.679m.

HORIZONTAL COORDINATES ARE IN TERMS OF NZ GEODETIC DATUM 2000, MOUNT PLEASANT 2000 CIRCUIT.
ORIGIN OF SURVEY: IS I DP361539
(798707.47mN 370018.15mE)

THE BOUNDARIES ON THIS PLAN SHOULD NOT BE RELIED UPON BY THEMSELVES, BUT MUST BE VERIFIED AGAINST THE LEGAL SURVEY PLAN BOUNDARIES TO CONFIRM THEIR ACCURACY.





www.aurecongroup.com




CLIENT


					SCALE 1:400
REV	DATE	REVISION DETAILS	APPROVED	DRAWN	DESIGNED
				R. DAWSON M.CROWE	
				CHECKED	
				K ASHBY	
				APPROVED	
				B TOMS	DATE 29/10/2018
				D TOM	ĺ
Α	29/10/18	ISSUE FOR INFORMATION	B TOMS	B.TOMS	

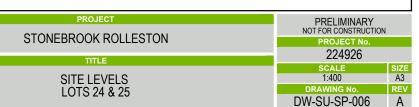


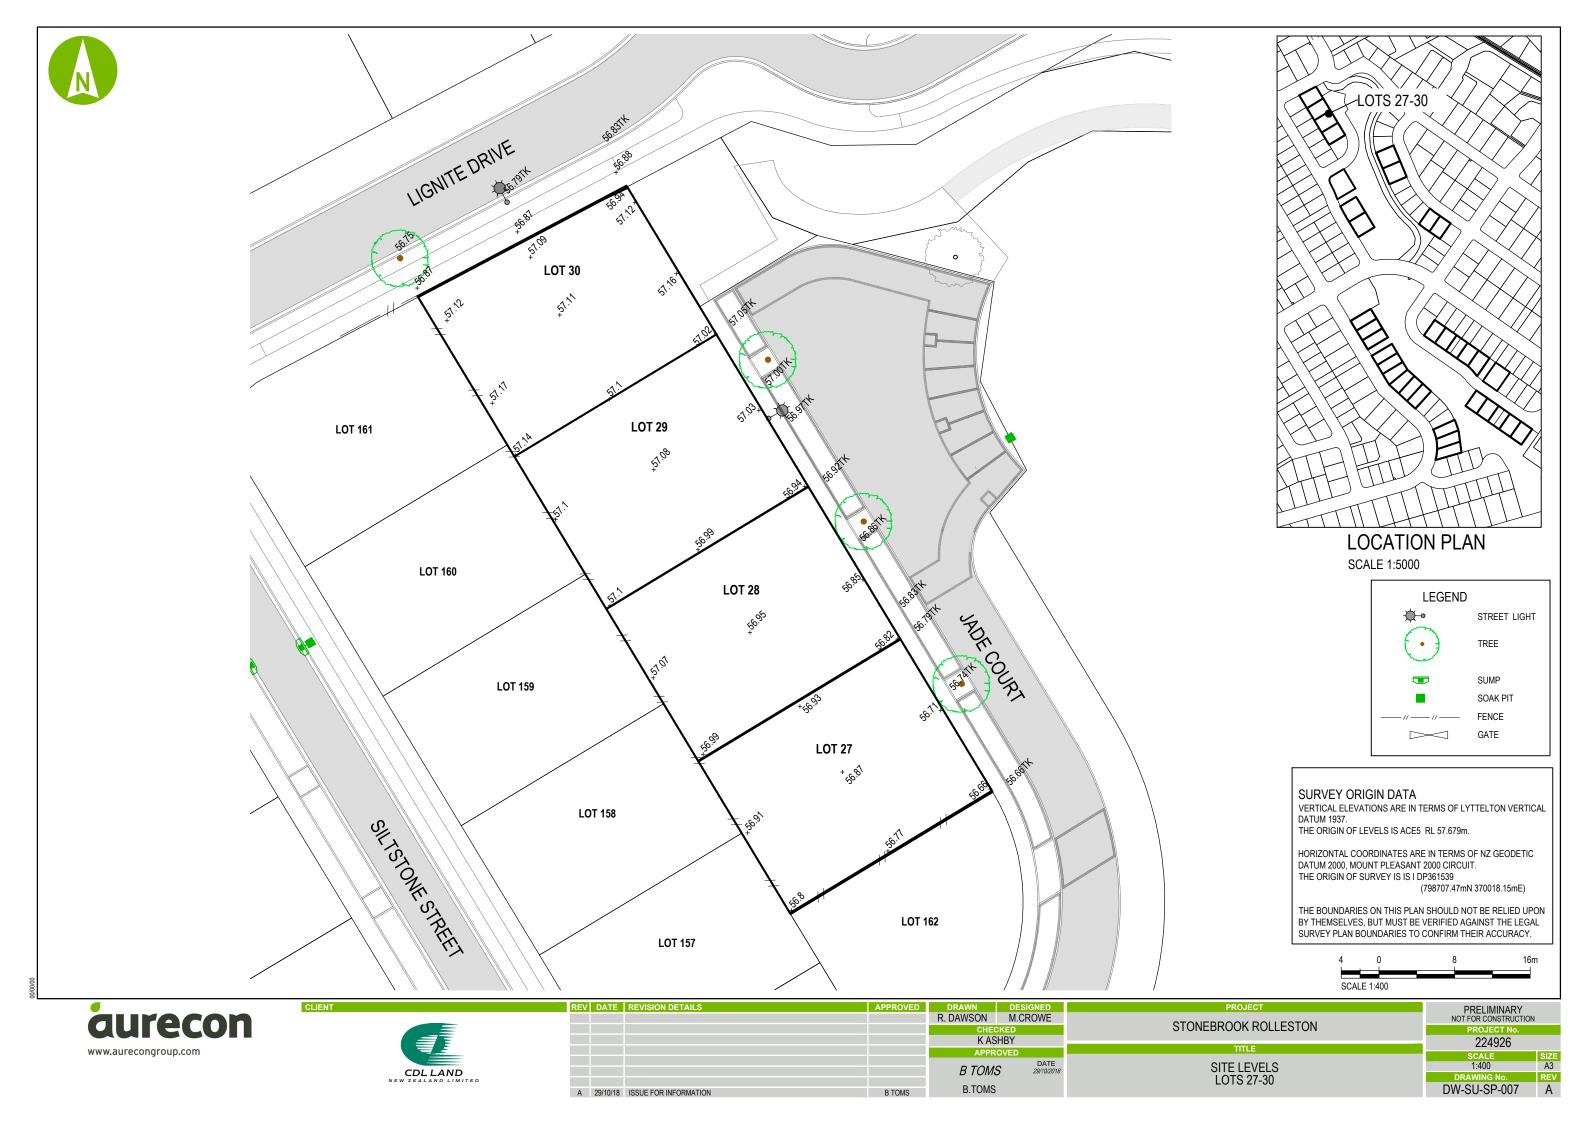




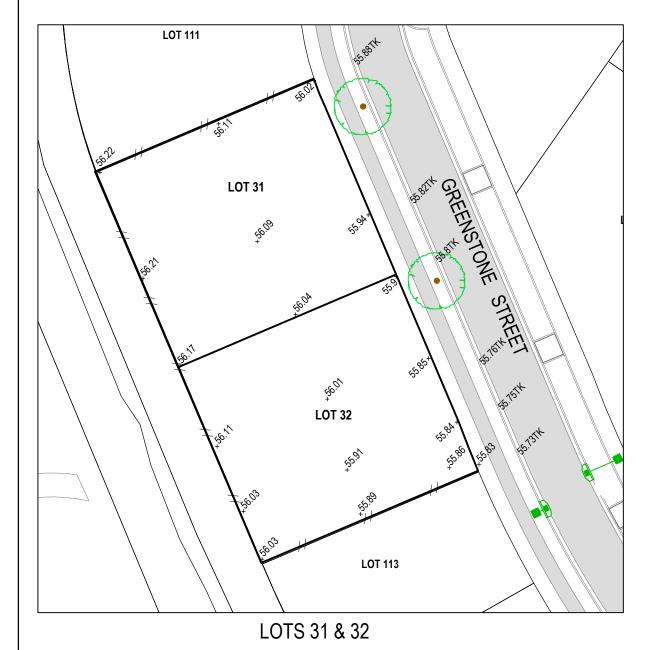

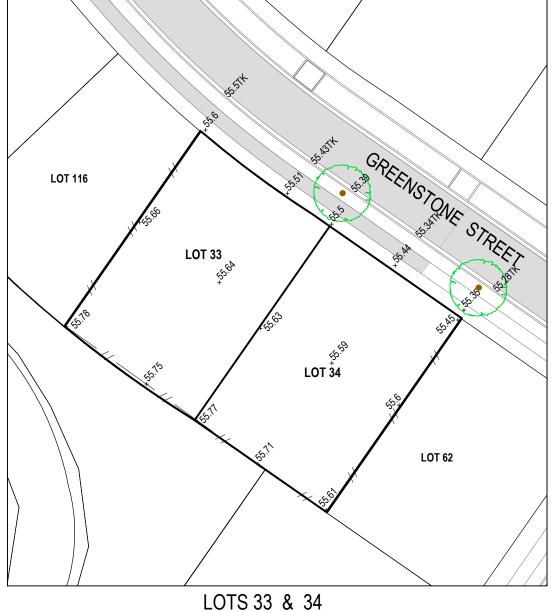

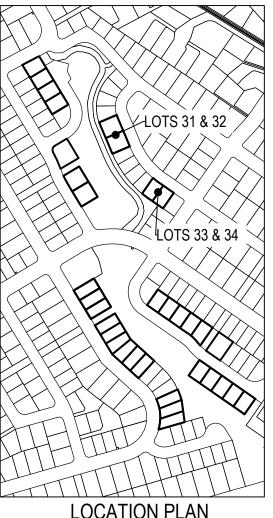

LOCATION PLAN SCALE 1:5000

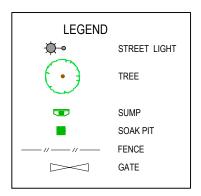

DW-SU-SP-008

SURVEY ORIGIN DATA

VERTICAL ELEVATIONS ARE IN TERMS OF LYTTELTON VERTICAL

DATUM 1937.
THE ORIGIN OF LEVELS IS ACE5 RL 57.679m.

HORIZONTAL COORDINATES ARE IN TERMS OF NZ GEODETIC DATUM 2000, MOUNT PLEASANT 2000 CIRCUIT.

ORIGIN OF SURVEY: IS I DP361539 (798707.47mN 370018.15mE)

THE BOUNDARIES ON THIS PLAN SHOULD NOT BE RELIED UPON BY THEMSELVES, BUT MUST BE VERIFIED AGAINST THE LEGAL SURVEY PLAN BOUNDARIES TO CONFIRM THEIR ACCURACY.



www.aurecongroup.com



CLIENT

					SCALE 1:400	
REV	DATE	REVISION DETAILS	APPROVED	DRAWN	DESIGNED	
				R. DAWSON	M.CROWE	
				CHECKED		
				K ASHBY		
				APPROVED		
				B TOMS	DATE 29/10/20	
Α	29/10/18	ISSUE FOR INFORMATION	B TOMS	B.TOMS		

PRELIMINARY NOT FOR CONSTRUCTION STONEBROOK ROLLESTON 224926 1:400 SITE LEVELS LOTS 31-34