


LOCATION PLAN
SCALE 1:5000

LEGEND	
	STREET LIGHT
	EXISTING TREE
	SUMP
	SOAK PIT
	TOBY / WATER LATERAL
	SEWER LATERAL

SURVEY ORIGIN DATA
 VERTICAL ELEVATIONS ARE IN TERMS OF LYTTELTON VERTICAL DATUM 1937.
 THE ORIGIN OF LEVELS IS ACE5 RL 57.679m.
 HORIZONTAL COORDINATES ARE IN TERMS OF NZ GEODETIC DATUM 2000, MOUNT PLEASANT 2000 CIRCUIT.
 ORIGIN OF SURVEY : IS 1 DP361539
 (798707.47mN 370018.15mE)
 THE BOUNDARIES ON THIS PLAN SHOULD NOT BE RELIED UPON BY THEMSELVES, BUT MUST BE VERIFIED AGAINST THE LEGAL SURVEY PLAN BOUNDARIES TO CONFIRM THEIR ACCURACY.

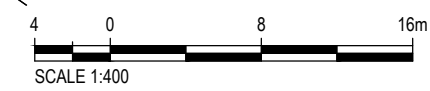

000000



CLIENT

REV	DATE	REVISION DETAILS	APPROVED
B	21/01/2019	AS-BUILT SEWER & WATER ADDED	B TOMS
A	29/10/18	ISSUE FOR INFORMATION	B TOMS

DRAWN	DESIGNED
R. DAWSON	M. CROWE
CHECKED	
K. ASHBY	
APPROVED	
B TOMS	DATE 29/10/2018
B. TOMS	

PROJECT
STONEBROOK ROLLESTON
TITLE
SITE LEVELS LOTS 1-5

PRELIMINARY NOT FOR CONSTRUCTION	
PROJECT No.	224926
SCALE	1:400
DRAWING No.	DW-SU-SP-001
SIZE	A3
REV	B